



- SITE PLAN NOTES:**
- 1 SEE GRADING AND DRAINAGE PLANS FOR STORMWATER IMPROVEMENTS.
 - 2 SEE PAVING PLANS FOR CURB, SIDEWALK, AND STRIPING DESIGN INFO.
 - 3 SEE ELECTRICAL PLANS FOR POWER SERVICE CONNECTION DESIGN INFO.
 - 4 SEE ITS PLANS FOR COMMUNICATIONS SERVICE CONNECTION DESIGN INFO.
 - 5 SEE UTILITY PLANS FOR UTILITY CONNECTION DESIGN INFO.

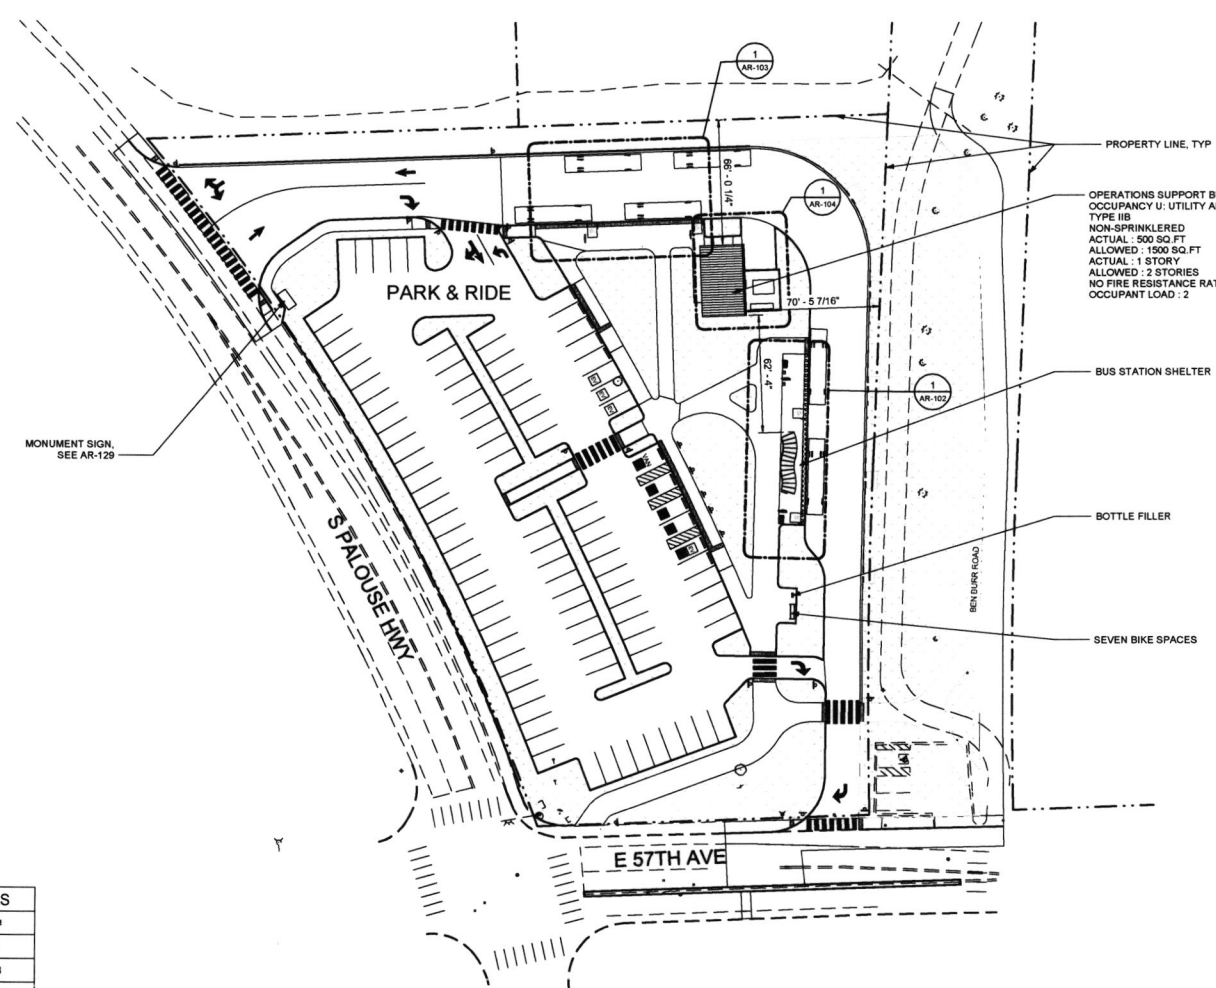

PARKING STALLS	
TYPE	#
VAN ACCESSIBLE	1
STD ACCESSIBLE	4
FUTURE CHARGING	3
GENERAL	93
TOTAL	101

* SEE C-101 FOR PARKING

ISSUED FOR CONSTRUCTION

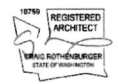

AR-101 of

NO.	DATE	REVISIONS	BY	CHKD.	APP'D.	DATE

AS BUILT

IBI GROUP
 801 Second Avenue - Suite 1400
 Spokane, WA 99201 USA
 Tel: (509) 325-0881 Fax: (509) 321-9996
 www.ibigroup.com

NAV888 DATUM

PROJECT NO:	DATE:	SCALE:

STANDARD: AS BUILT



SPOKANE TRANSIT AUTHORITY
 PLANNING DEPARTMENT
 1320 W. PINE AVENUE
 SPOKANE, WASHINGTON 99201
 (509) 325-7443

PROJECT NAME:	MORAN STATION PARK AND RIDE	
ISSUED DATE:	STATION PLAN	
ISSUED BY:	SITE PLAN	
PROJECT NUMBER:	2019-10299	