


S. 18 T.25N., R.45E., W.M.



NO.	DATE	DESCRIPTION
1	11/11/11	ISSUED FOR PERMITS
2	11/11/11	ISSUED FOR PERMITS

SEE ATTACHED EXHIBITS AND NOTES FOR THE LOCATION OF THE PROPOSED ROAD AND THE LOCATION OF THE EXISTING ROAD. THE ROAD SHALL BE CONSTRUCTED TO THE STANDARDS OF THE WASH. STATE DEPARTMENT OF TRANSPORTATION.

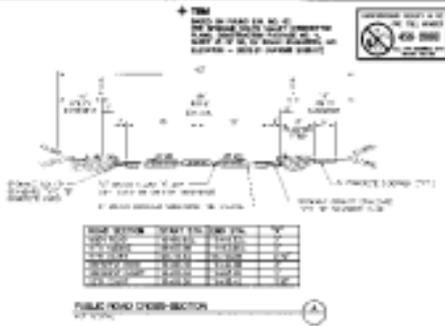

ROAD CROSS SECTION AS TO THE LOCATION OF THE PROPOSED ROAD AND THE LOCATION OF THE EXISTING ROAD. THE ROAD SHALL BE CONSTRUCTED TO THE STANDARDS OF THE WASH. STATE DEPARTMENT OF TRANSPORTATION.

Project No.	11-11-11
Sheet No.	2
Scale	1" = 40'
Date	11/11/11
Author	AS-PAULY
Checker	AS-PAULY
Engineer	AS-PAULY


Taylor Engineering, Inc.
 1000 N. 1st Street, Suite 100
 Spokane, WA 99201
 Phone: (509) 325-1111
 Fax: (509) 325-1112
 www.taylor-engineering.com

SPOKANE COUNTY PUBLIC WORKS
 DIVISION OF ENGINEERING AND PLANNING
 1000 N. 1st Street, Suite 100
 Spokane, WA 99201
 Phone: (509) 325-1111
 Fax: (509) 325-1112
 www.spcwa.gov

AS-PAULY
 LICENSED PROFESSIONAL ENGINEER
 WASHINGTON STATE
 License No. 111111
 Exp. 12/31/12


ROAD CROSS SECTION
 FROM STA. 14+00 TO STA. 19+00

SCALE
 HORIZ. 1" = 40'
 VERT. 1" = 10'

ROAD CROSS SECTION
 FROM STA. 14+00 TO STA. 19+00
 SHEET 2
 OF 10

TURTLE CREEK SOUTH SECOND & THIRD ADDITIONS STORMWATER MASTER PLAN

PROJECT NO. 10-000
DATE: 10-20-00
SCALE: AS SHOWN

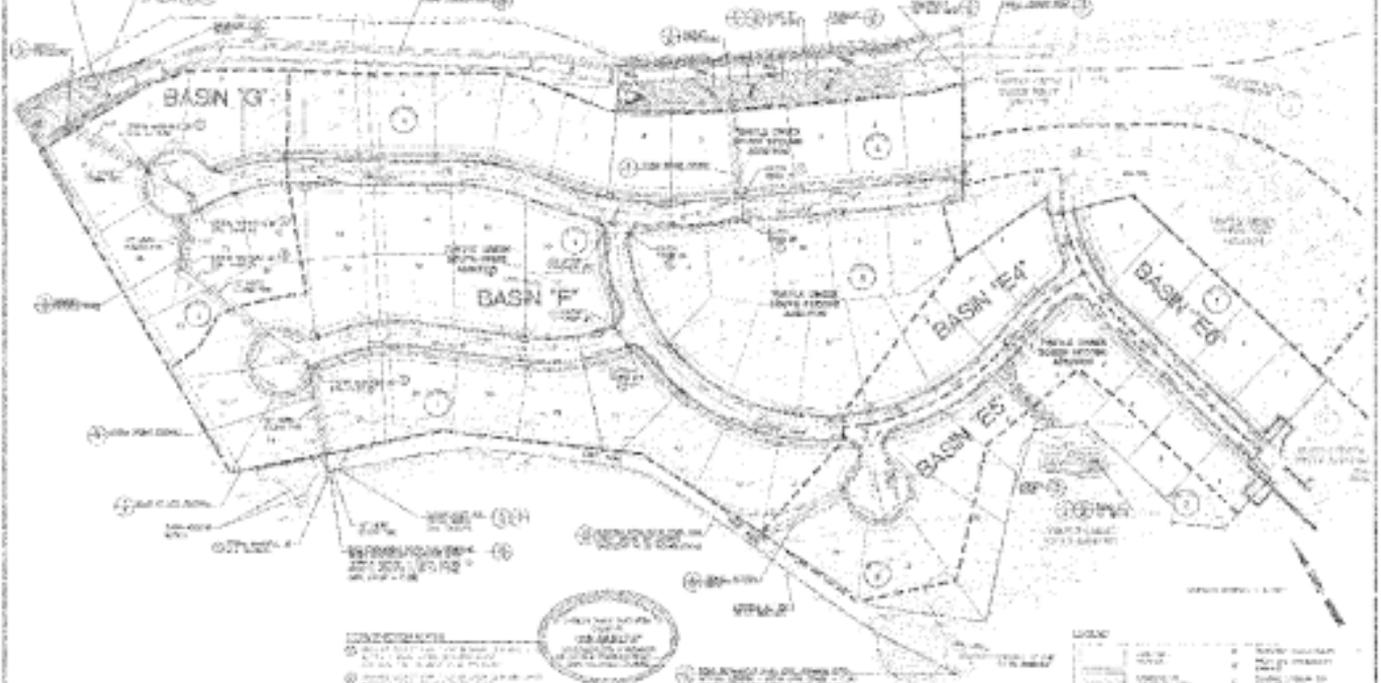

- CONVENTIONS**
- 12" DIA. MANHOLE
 - 18" DIA. MANHOLE
 - 24" DIA. MANHOLE
 - 30" DIA. MANHOLE
 - 36" DIA. MANHOLE
 - 42" DIA. MANHOLE
 - 48" DIA. MANHOLE
 - 54" DIA. MANHOLE
 - 60" DIA. MANHOLE
 - 66" DIA. MANHOLE
 - 72" DIA. MANHOLE
 - 78" DIA. MANHOLE
 - 84" DIA. MANHOLE
 - 90" DIA. MANHOLE
 - 96" DIA. MANHOLE
 - 102" DIA. MANHOLE
 - 108" DIA. MANHOLE
 - 114" DIA. MANHOLE
 - 120" DIA. MANHOLE

MANHOLE DEPTH TO CENTER OF MANHOLE

- LEGEND**
- 12" DIA. MANHOLE
 - 18" DIA. MANHOLE
 - 24" DIA. MANHOLE
 - 30" DIA. MANHOLE
 - 36" DIA. MANHOLE
 - 42" DIA. MANHOLE
 - 48" DIA. MANHOLE
 - 54" DIA. MANHOLE
 - 60" DIA. MANHOLE
 - 66" DIA. MANHOLE
 - 72" DIA. MANHOLE
 - 78" DIA. MANHOLE
 - 84" DIA. MANHOLE
 - 90" DIA. MANHOLE
 - 96" DIA. MANHOLE
 - 102" DIA. MANHOLE
 - 108" DIA. MANHOLE
 - 114" DIA. MANHOLE
 - 120" DIA. MANHOLE

STORMWATER MASTER PLAN

NO.	DATE	REVISION
1	10-20-00	ISSUE FOR PERMIT



OWNER: **WYOMING COUNTY PUBLIC WORKS**
 ADDRESS: 1000 N. 14th St., P.O. Box 1000, Cheyenne, WY 82002
 PHONE: (307) 773-3300

DESIGNED BY: **WYOMING COUNTY PUBLIC WORKS**
 ENGINEER: **WYOMING COUNTY PUBLIC WORKS**

DATE: 10-20-00
 SCALE: AS SHOWN

PROJECT NO. 10-000

PROJECT NO.	10-000
DATE	10-20-00
SCALE	AS SHOWN
PROJECT NAME	TURTLE CREEK SOUTH SECOND & THIRD ADDITIONS
PROJECT LOCATION	AS SHOWN
PROJECT AREA	AS SHOWN
PROJECT STATUS	AS SHOWN


1. The
 2. The
 3. The
 4. The
 5. The
 6. The
 7. The
 8. The
 9. The
 10. The



1. PROPOSED ROAD
 2. EXISTING ROAD



1. PROPOSED ROAD
 2. EXISTING ROAD

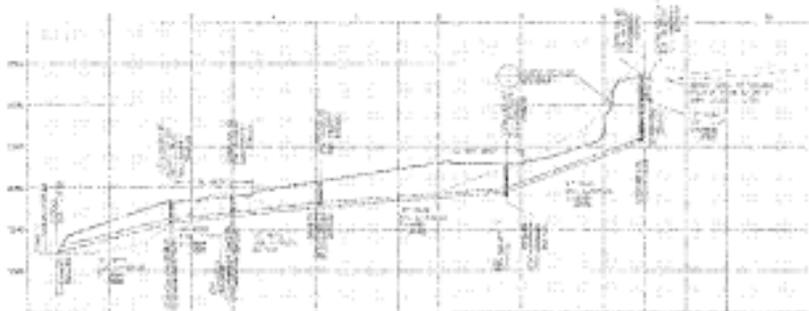

1. THIS PLAN IS PREPARED BY THE
 DIVISION OF ENGINEERING AND ROAD
 CONSTRUCTION OF THE
 SPOKANE COUNTY PUBLIC WORKS DEPARTMENT



TABLE A

PIER	1	2	3
ABUTMENT	1	2	3
ROADWAY	1	2	3
RAILROAD	1	2	3

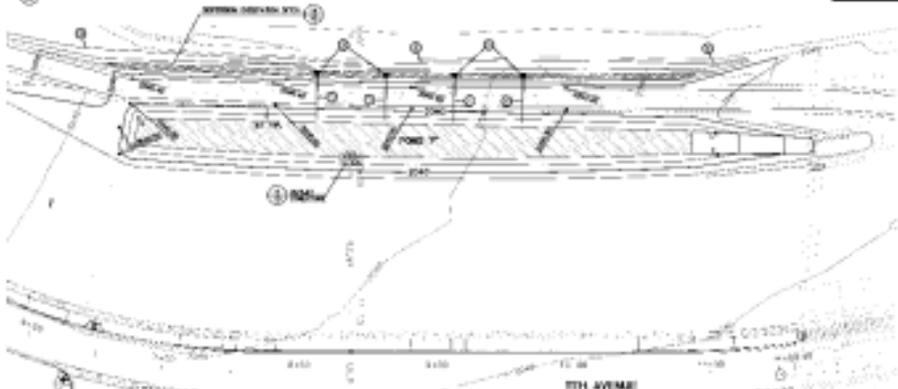


TABLE B

PIER	1	2	3
ABUTMENT	1	2	3
ROADWAY	1	2	3
RAILROAD	1	2	3



TABLE C

PIER	1	2	3
ABUTMENT	1	2	3
ROADWAY	1	2	3
RAILROAD	1	2	3

GENERAL NOTES

1. THE BRIDGE IS A BEAM TYPE BRIDGE AND SHALL BE CONSTRUCTED OF CAST IRON PILES AND STEEL BEAMS. THE BRIDGE IS TO BE CONSTRUCTED ON THE EXISTING GRADE OF THE RAILROAD TRACKS. THE BRIDGE IS TO BE CONSTRUCTED ON THE EXISTING GRADE OF THE RAILROAD TRACKS. THE BRIDGE IS TO BE CONSTRUCTED ON THE EXISTING GRADE OF THE RAILROAD TRACKS.
2. ALL WORK ON THE BRIDGE SHALL BE DONE IN ACCORDANCE WITH THE SPECIFICATIONS OF THE BRIDGE ENGINEER.



CONTRACTOR NOTES

1. THE CONTRACTOR SHALL BE RESPONSIBLE FOR OBTAINING ALL NECESSARY PERMITS AND APPROVALS.
2. THE CONTRACTOR SHALL BE RESPONSIBLE FOR OBTAINING ALL NECESSARY PERMITS AND APPROVALS.

DATE	NOV 10 1910
BY	J. H. BROWN
CHECKED	J. H. BROWN
APPROVED	J. H. BROWN

DATE	NOV 10 1910
BY	J. H. BROWN
CHECKED	J. H. BROWN
APPROVED	J. H. BROWN



Taylor Engineering, Inc.
 1000 Broadway, Spokane, Wash.
 Phone 444-1001, 444-1002, 444-1003

SPOKANE COUNTY PUBLIC WORKS
DIVISION OF ENGINEERING AND ROAD
 1000 Broadway, Spokane, Wash.
 Phone 444-1001, 444-1002, 444-1003

PROJECT NO.	1000
DATE	NOV 10 1910
BY	J. H. BROWN
CHECKED	J. H. BROWN
APPROVED	J. H. BROWN

SCALE	1" = 10'
DATE	NOV 10 1910

PROJECT NO.	1000
DATE	NOV 10 1910
BY	J. H. BROWN
CHECKED	J. H. BROWN
APPROVED	J. H. BROWN

PROJECT NO.	1000
DATE	NOV 10 1910
BY	J. H. BROWN
CHECKED	J. H. BROWN
APPROVED	J. H. BROWN

