




PROJECT MAP

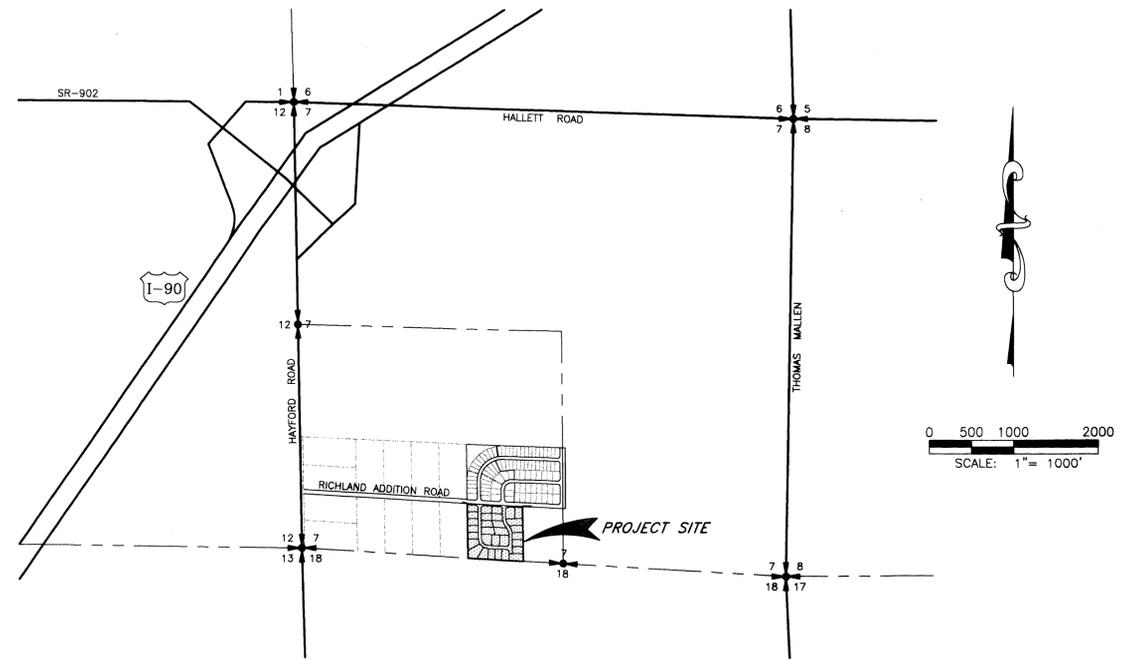

VICINITY MAP

SECTION 7, TOWNSHIP 24 NORTH, RANGE 42 EAST

RECORD DRAWING for

SAN. SEWER WATER DISTRIBUTION STREET/ROAD DRAINAGE

OTHER

1. INFORMATION OBTAINED FROM:
LANDTEK SURVEYORS Post-CONSTRUCTION SURVEY & METRO ENGINEERING SITE VISITS

2. CONTRACTOR: MURPHY BROTHERS
 CONSTRUCTION PERIOD: SPRING - FALL 2003

3. DRAWING REVISIONS BY: JKO DATE: 10/11/04

4. CHECKED BY: RMS DATE: 10/12/04



RECORD DRAWING STATEMENT: I have reviewed the construction and to my knowledge find it to be in substantial conformance with the approved plans and standard specifications except as noted.

RECORD DATA


SHEET INDEX

- 1 COVER SHEET
- 2 RICHLAND ROAD Street Plan and Profile
- 3 BLACKBERRY STREET Street Plan and Profile
- 4 STRAWBERRY STREET Street Plan and Profile
- 5 OVERALL DRAINAGE & EROSION CONTROL PLAN

BASIS OF ELEVATION

PLAN DATUM:
 USC&GS VERTICAL DATUM (1929)
 FROM USCA&GS BENCH MARK NO. 354

NAV88 DATUM:
 PLAN DATUM + 3.80' = NAV88 DATUM

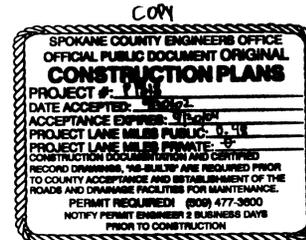

ENGINEER'S STATEMENT:

THE DESIGN IMPROVEMENTS SHOWN IN THIS SET OF PLANS AND CALCULATIONS CONFORM TO THE APPLICABLE EDITIONS OF THE SPOKANE COUNTY STANDARDS FOR ROAD AND SEWER CONSTRUCTION AND THE SPOKANE COUNTY GUIDELINES FOR STORMWATER MANAGEMENT. ALL DESIGN DEVIATIONS HAVE BEEN APPROVED BY THE SPOKANE COUNTY ENGINEER. I APPROVE THESE PLANS FOR CONSTRUCTION.

CONSTRUCTION NOTES:

- 1) ALL ITEMS OF CONSTRUCTION SHALL BE COMPLETED IN ACCORDANCE WITH THE 2000 STANDARD SPECIFICATIONS FOR ROAD, BRIDGE, AND MUNICIPAL CONSTRUCTION AS PROMULGATED JOINTLY BY THE WASHINGTON STATE DEPARTMENT OF TRANSPORTATION (WSDOT) AND THE AMERICAN PUBLIC WORKS ASSOCIATION (APWA); THE 1995 SPOKANE COUNTY STANDARDS FOR ROAD AND SEWER CONSTRUCTION; AND ALL AMENDMENTS HERETO.
- 2) PRIOR TO SITE CONSTRUCTION, THE CONTRACTOR SHALL BE RESPONSIBLE FOR LOCATING ALL UNDERGROUND UTILITIES. CALL THE UNDERGROUND UTILITY LOCATION SERVICE AT 456-8000 BEFORE YOU DIG. ANY CONFLICTING UTILITIES SHALL BE RELOCATED PRIOR TO CONSTRUCTION OF ROAD AND DRAINAGE FACILITIES.
- 3) THE CONTRACTOR IS REQUIRED TO HAVE A COMPLETE SET OF THE APPROVED ROAD AND DRAINAGE PLANS ON THE JOB SITE WHENEVER CONSTRUCTION IS IN PROGRESS.
- 4) IF THE CONTRACTOR DISCOVERS ANY DISCREPANCIES BETWEEN THE PLANS AND EXISTING CONDITIONS ENCOUNTERED, THE CONTRACTOR SHALL IMMEDIATELY NOTIFY THE DESIGN ENGINEER AND THE SPOKANE COUNTY ENGINEER'S OFFICE.

Richard J. Bayden 9-27-02
 DEVELOPER'S APPROVAL DATE

METRO ENGINEERING, INC.
 S. 324 SHERMAN
 SPOKANE, WA 99202
 (509) 624-9351




DRAWN BY: JKO
 CHECKED BY: JGL
 DATE: 09/24/02
 SCALE: AS SHOWN

**WEST TERRACE HEIGHTS/
 WEST TERRACE HEIGHTS 1st ADD.
 COVER SHEET**

SHEET
 1 OF 5
 98-026.2

8026-COV.DWG XREF: 8026BASE.DWG, 8026BASE.DWG

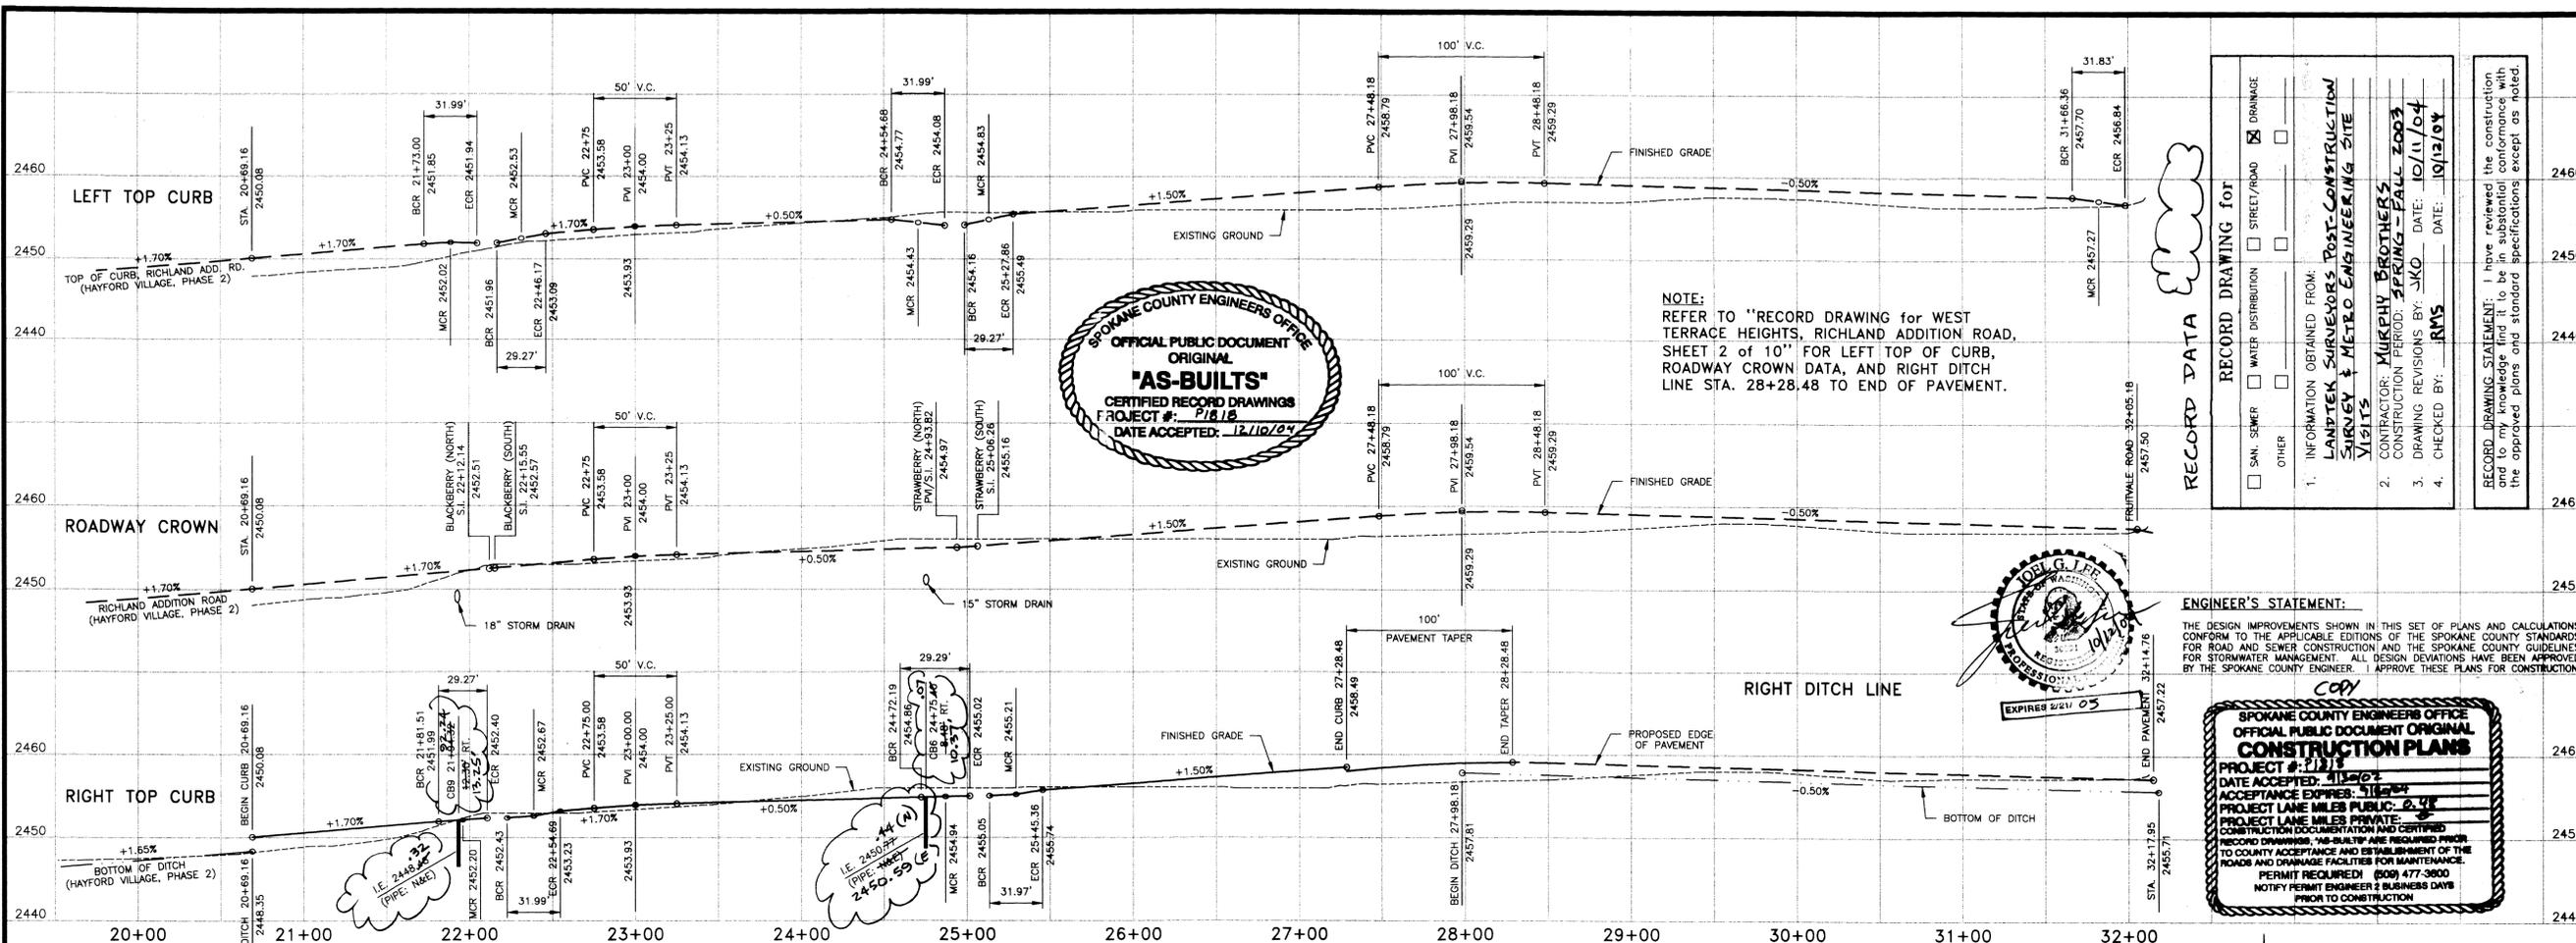

SPOKANE COUNTY ENGINEERS OFFICE
OFFICIAL PUBLIC DOCUMENT
ORIGINAL
"AS-BUILTS"
CERTIFIED RECORD DRAWINGS
PROJECT #: P1818
DATE ACCEPTED: 12/10/04

NOTE:
 REFER TO "RECORD DRAWING FOR WEST TERRACE HEIGHTS, RICHLAND ADDITION ROAD, SHEET 2 OF 10" FOR LEFT TOP OF CURB, ROADWAY CROWN DATA, AND RIGHT DITCH LINE STA. 28+28.48 TO END OF PAVEMENT.

RECORD DATA

RECORD DRAWING FOR:
 SAN. SEWER
 WATER DISTRIBUTION
 STREET/ROAD
 DRAINAGE
 OTHER



INFORMATION OBTAINED FROM:
 1. LANDTEK SURVEYORS POST-CONSTRUCTION SURVEY & METRO ENGINEERING SITE VISITS
 2. CONTRACTOR: MURPHY BROTHERS CONSTRUCTION PERIOD: SPRING - FALL 2003
 3. DRAWING REVISIONS: BY: JKO DATE: 10/11/04
 4. CHECKED BY: RMS DATE: 10/12/04

RECORD DRAWING STATEMENT: I have reviewed the construction and to my knowledge find it to be in substantial conformance with the approved plans and standard specifications, except as noted.

ENGINEER'S STATEMENT:

THE DESIGN IMPROVEMENTS SHOWN IN THIS SET OF PLANS AND CALCULATIONS CONFORM TO THE APPLICABLE EDITIONS OF THE SPOKANE COUNTY STANDARDS FOR ROAD AND SEWER CONSTRUCTION AND THE SPOKANE COUNTY GUIDELINES FOR STORMWATER MANAGEMENT. ALL DESIGN DEVIATIONS HAVE BEEN APPROVED BY THE SPOKANE COUNTY ENGINEER'S OFFICE. I APPROVE THESE PLANS FOR CONSTRUCTION.

SPOKANE COUNTY ENGINEERS OFFICE
OFFICIAL PUBLIC DOCUMENT ORIGINAL
CONSTRUCTION PLANS
PROJECT #: P1818
DATE ACCEPTED: 11/20/04
ACCEPTANCE EXPIRES: 11/20/07
PROJECT LAKE MILES PUBLIC: 2.01
PROJECT LAKE MILES PRIVATE: 0.00
CONSTRUCTION DOCUMENTS ARE CERTIFIED RECORD DRAWINGS. "AS-BUILTS" ARE REQUIRED PRIOR TO COUNTY ACCEPTANCE AND ESTABLISHMENT OF THE ROADS AND DRAINAGE FACILITIES FOR MAINTENANCE. PERMIT REQUIRED! (509) 477-3800. NOTIFY PERMIT ENGINEER 2 BUSINESS DAYS PRIOR TO CONSTRUCTION.

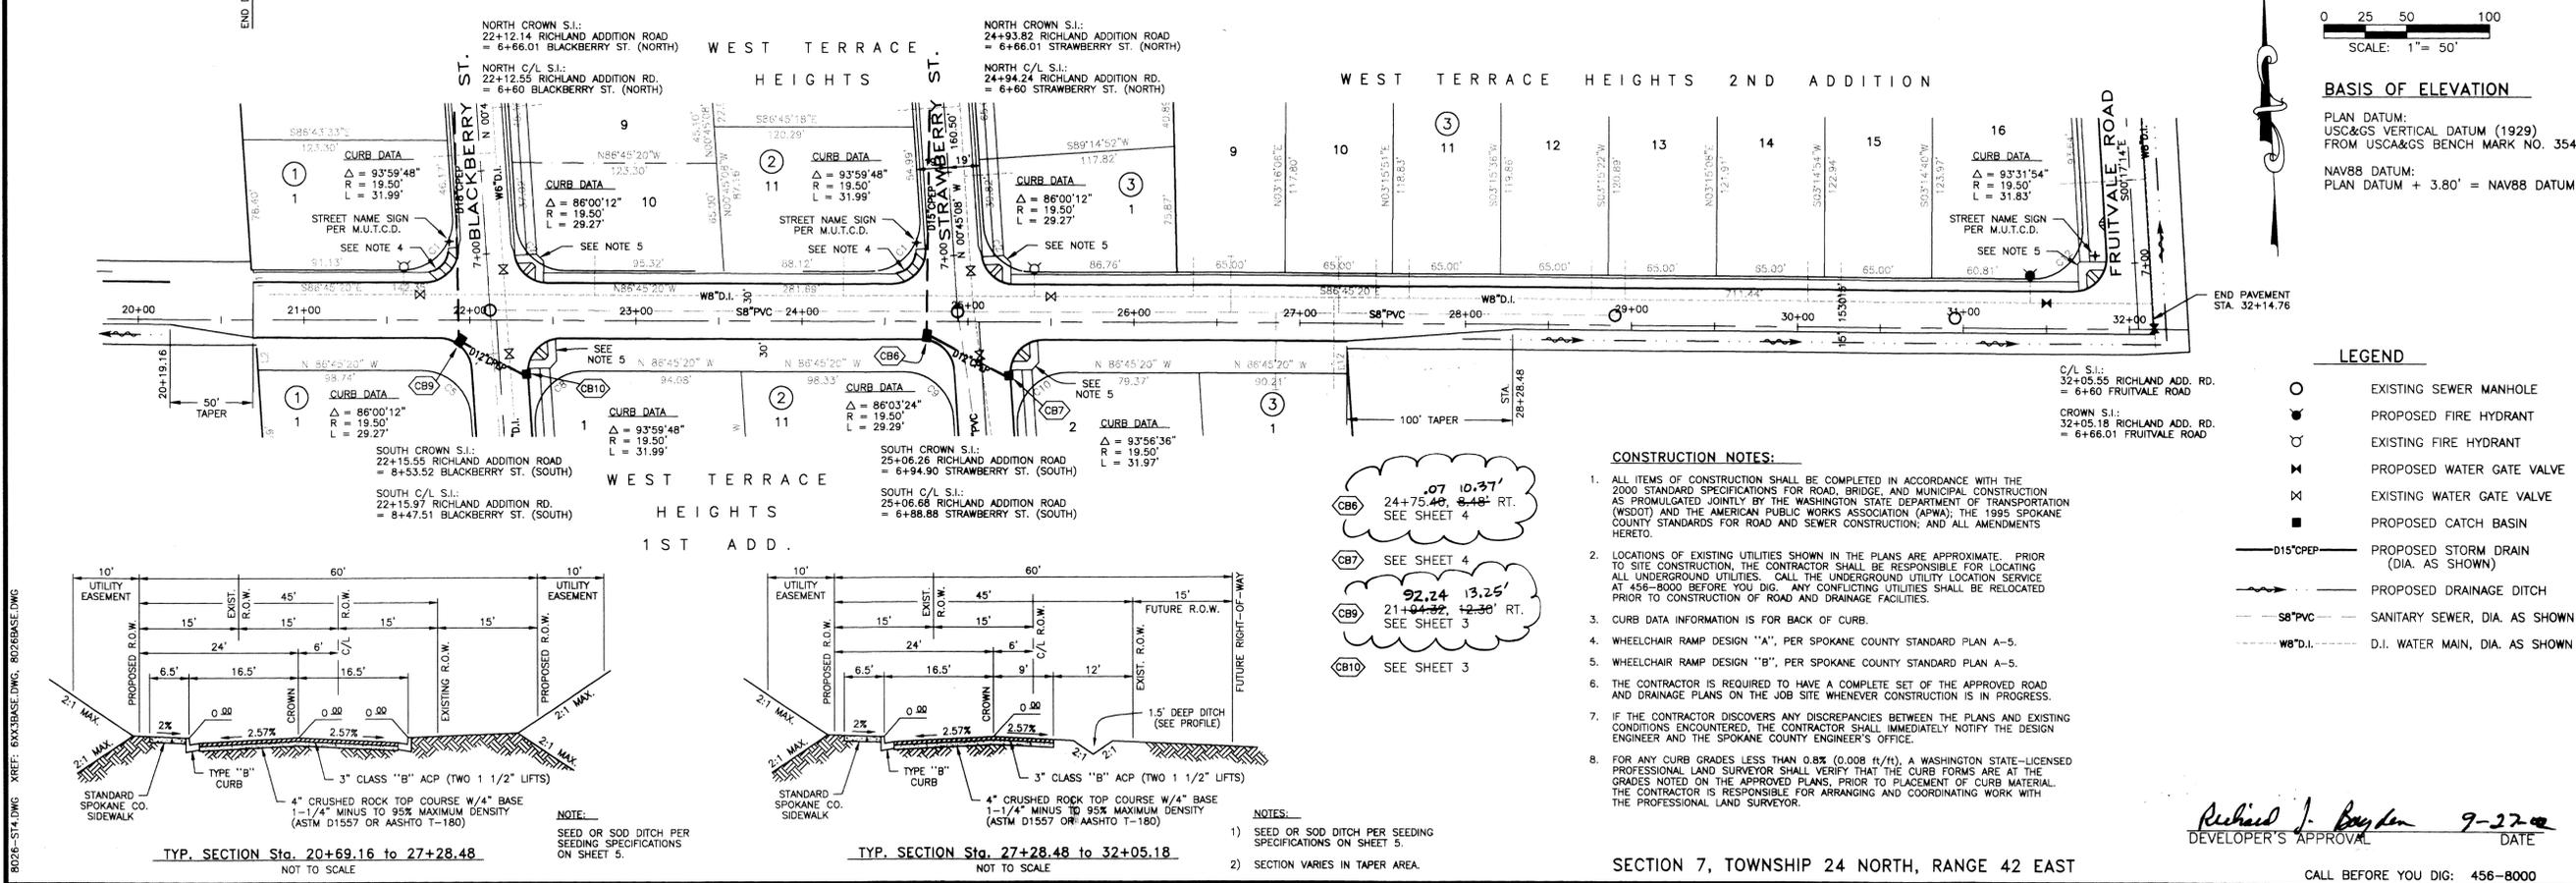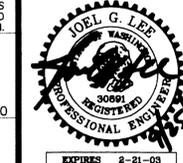



BASIS OF ELEVATION

PLAN DATUM:
 USC&GS VERTICAL DATUM (1929)
 FROM USCA&GS BENCH MARK NO. 354

NAV88 DATUM:
 PLAN DATUM + 3.80' = NAV88 DATUM

- LEGEND**
- EXISTING SEWER MANHOLE
 - PROPOSED FIRE HYDRANT
 - ⊗ EXISTING FIRE HYDRANT
 - ⊗ PROPOSED WATER GATE VALVE
 - ⊗ EXISTING WATER GATE VALVE
 - PROPOSED CATCH BASIN
 - D15°CPEP— PROPOSED STORM DRAIN (DIA. AS SHOWN)
 - SBPVC— PROPOSED DRAINAGE DITCH
 - WB'D.I.— SANITARY SEWER, DIA. AS SHOWN
 - WB'D.I.— D.I. WATER MAIN, DIA. AS SHOWN

- CONSTRUCTION NOTES:**
- ALL ITEMS OF CONSTRUCTION SHALL BE COMPLETED IN ACCORDANCE WITH THE 2000 STANDARD SPECIFICATIONS FOR ROAD, BRIDGE, AND MUNICIPAL CONSTRUCTION AS PROMULGATED JOINTLY BY THE WASHINGTON STATE DEPARTMENT OF TRANSPORTATION (WSDOT) AND THE AMERICAN PUBLIC WORKS ASSOCIATION (APWA), THE 1995 SPOKANE COUNTY STANDARDS FOR ROAD AND SEWER CONSTRUCTION, AND ALL AMENDMENTS HERETO.
 - LOCATIONS OF EXISTING UTILITIES SHOWN IN THE PLANS ARE APPROXIMATE. PRIOR TO SITE CONSTRUCTION, THE CONTRACTOR SHALL BE RESPONSIBLE FOR LOCATING ALL UNDERGROUND UTILITIES, CALL THE UNDERGROUND UTILITY LOCATION SERVICE AT 458-8000 BEFORE YOU DIG. ANY CONFLICTING UTILITIES SHALL BE RELOCATED PRIOR TO CONSTRUCTION OF ROAD AND DRAINAGE FACILITIES.
 - CURB DATA INFORMATION IS FOR BACK OF CURB.
 - WHEELCHAIR RAMP DESIGN "A", PER SPOKANE COUNTY STANDARD PLAN A-5.
 - WHEELCHAIR RAMP DESIGN "B", PER SPOKANE COUNTY STANDARD PLAN A-5.
 - THE CONTRACTOR IS REQUIRED TO HAVE A COMPLETE SET OF THE APPROVED ROAD AND DRAINAGE PLANS ON THE JOB SITE WHENEVER CONSTRUCTION IS IN PROGRESS.
 - IF THE CONTRACTOR DISCOVERS ANY DISCREPANCIES BETWEEN THE PLANS AND EXISTING CONDITIONS ENCOUNTERED, THE CONTRACTOR SHALL IMMEDIATELY NOTIFY THE DESIGN ENGINEER AND THE SPOKANE COUNTY ENGINEER'S OFFICE.
 - FOR ANY CURB GRADES LESS THAN 0.8% (0.008 ft/ft), A WASHINGTON STATE-LICENSED PROFESSIONAL LAND SURVEYOR SHALL VERIFY THAT THE CURB FORMS ARE AT THE GRADES NOTED ON THE APPROVED PLANS, PRIOR TO PLACEMENT OF CURB MATERIAL. THE CONTRACTOR IS RESPONSIBLE FOR ARRANGING AND COORDINATING WORK WITH THE PROFESSIONAL LAND SURVEYOR.

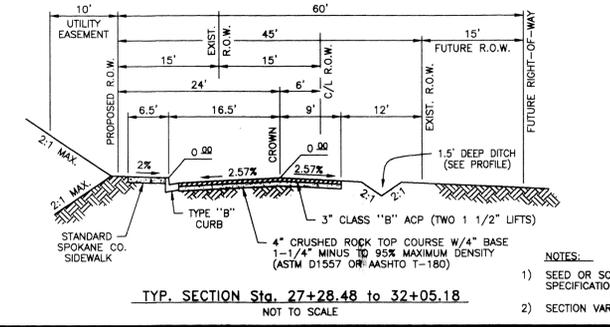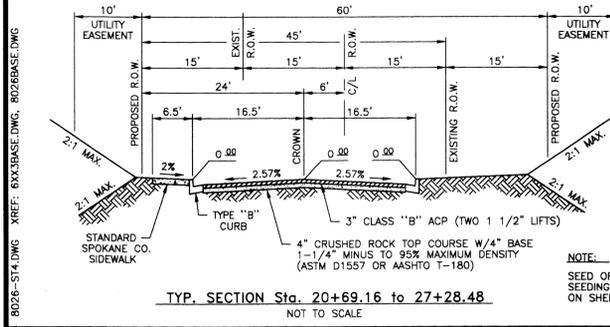

METRO ENGINEERING, INC.
 S. 324 SHERMAN
 SPOKANE, WA 99202
 (509) 624-9351


**WEST TERRACE HEIGHTS/
 WEST TERRACE HEIGHTS 1st ADD.**
 Richland Add. Rd. Plan & Profile, Sta. 20+19 to 32+05

DRAWN BY: JKO
 CHECKED BY: JGL
 DATE: 09/24/02
 SCALE: AS SHOWN

SHEET
 2 OF 5
 98-026.2

CALL BEFORE YOU DIG: 456-8000

P-1818 Eng As-Built

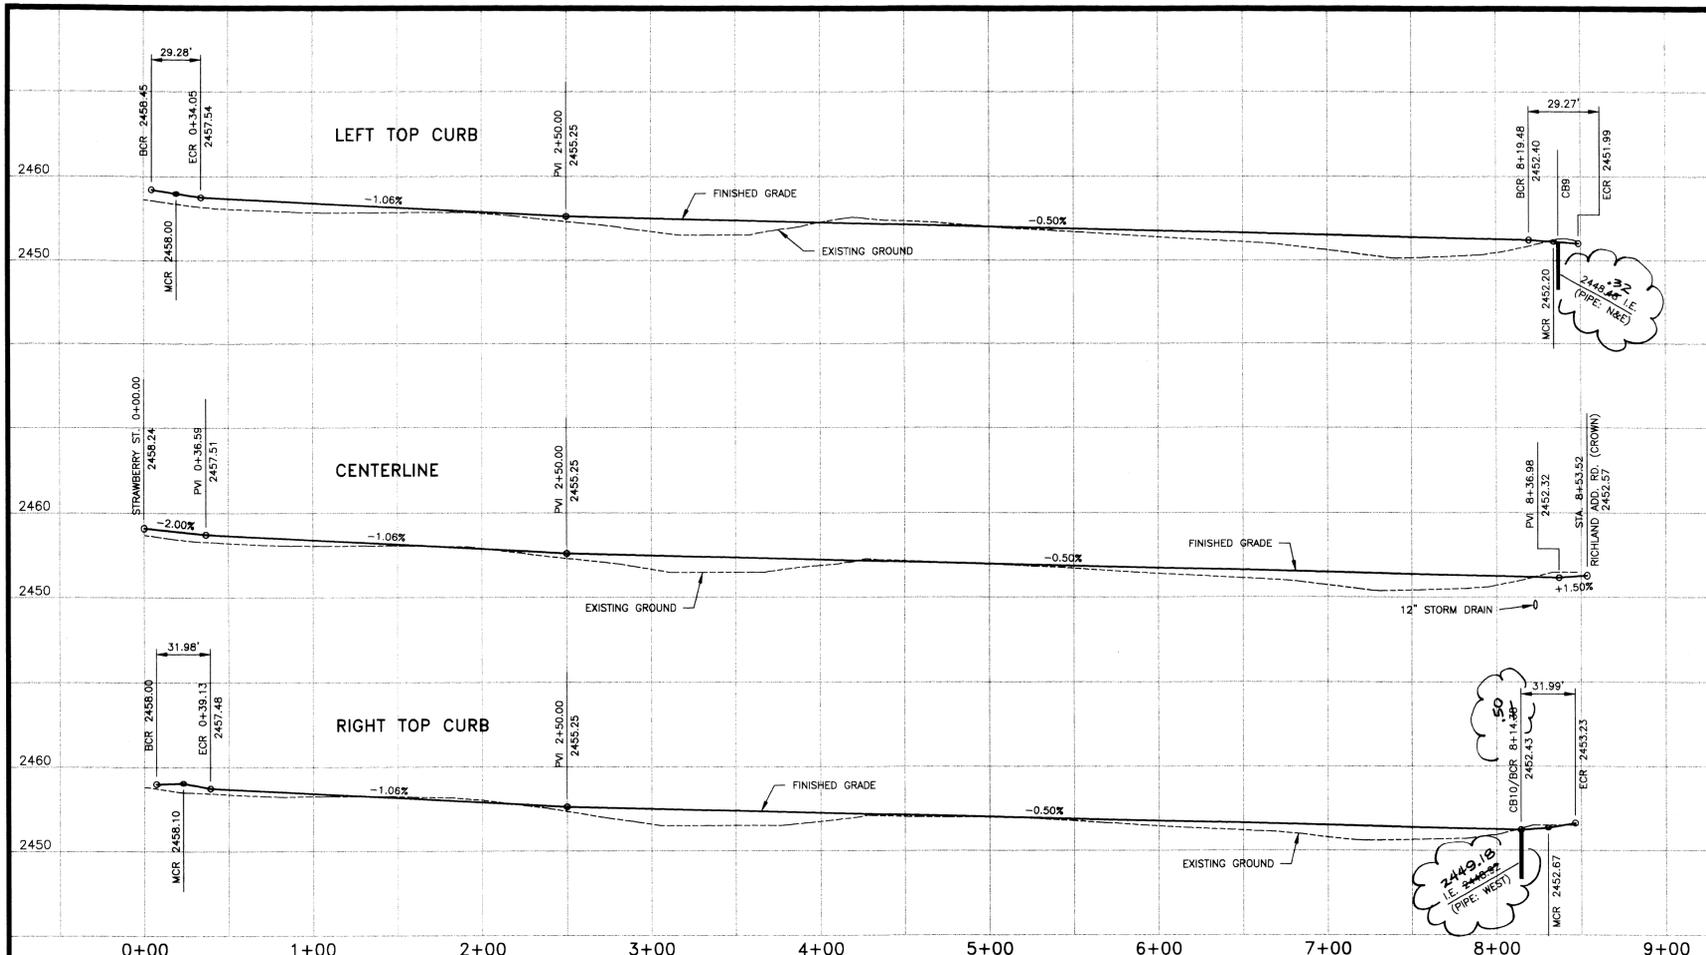


RECORD DRAWING for			
<input type="checkbox"/> SAN. SEWER	<input type="checkbox"/> WATER DISTRIBUTION	<input type="checkbox"/> STREET/ROAD	<input checked="" type="checkbox"/> DRAINAGE
OTHER <input type="checkbox"/>			
1. INFORMATION OBTAINED FROM: LANDEK SURVEYORS POST-CONSTRUCTION SURVEY & METRO ENGINEERING SITE VISIT			
2. CONTRACTOR: MURPHY BROTHERS CONSTRUCTION PERIOD: SPRING - FALL 2003			
3. DRAWING REVISIONS BY: JKO DATE: 10/11/04			
4. CHECKED BY: RMS DATE: 10/12/04			

RECORD DRAWING STATEMENT: I have reviewed the construction and to my knowledge find it to be in substantial conformance with the approved plans and standard specifications except as noted.


RECORD DATA

STORM DRAIN PROFILE

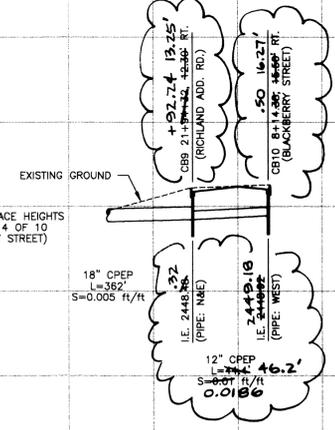

SPokane County Engineers Office
OFFICIAL PUBLIC DOCUMENT ORIGINAL
CONSTRUCTION PLANS
 PROJECT #: **P1818**
 DATE ACCEPTED: **12/10/04**
 ACCEPTANCE EXPIRES: **11/26/04**
 PROJECT LANE MILES PUBLIC: **0.11**
 PROJECT LANE MILES PRIVATE: **0.00**
 CONSTRUCTION DOCUMENTATION AND CERTIFIED RECORD DRAWINGS ARE REQUIRED PRIOR TO COUNTY ACCEPTANCE AND ESTABLISHMENT OF THE ROADS AND DRAINAGE FACILITIES FOR MAINTENANCE.
 PERMIT REQUIRED! (509) 477-3800
 NOTIFY PERMIT ENGINEER 2 BUSINESS DAYS PRIOR TO CONSTRUCTION

ENGINEER'S STATEMENT: THE DESIGN IMPROVEMENTS SHOWN IN THIS SET OF PLANS AND CALCULATIONS CONFORM TO THE APPLICABLE EDITIONS OF THE SPOKANE COUNTY STANDARDS FOR ROAD AND SEWER CONSTRUCTION AND THE SPOKANE COUNTY GUIDELINES FOR STORMWATER MANAGEMENT. ALL DESIGN DEVIATIONS HAVE BEEN APPROVED BY THE SPOKANE COUNTY ENGINEER. I APPROVE THESE PLANS FOR CONSTRUCTION.

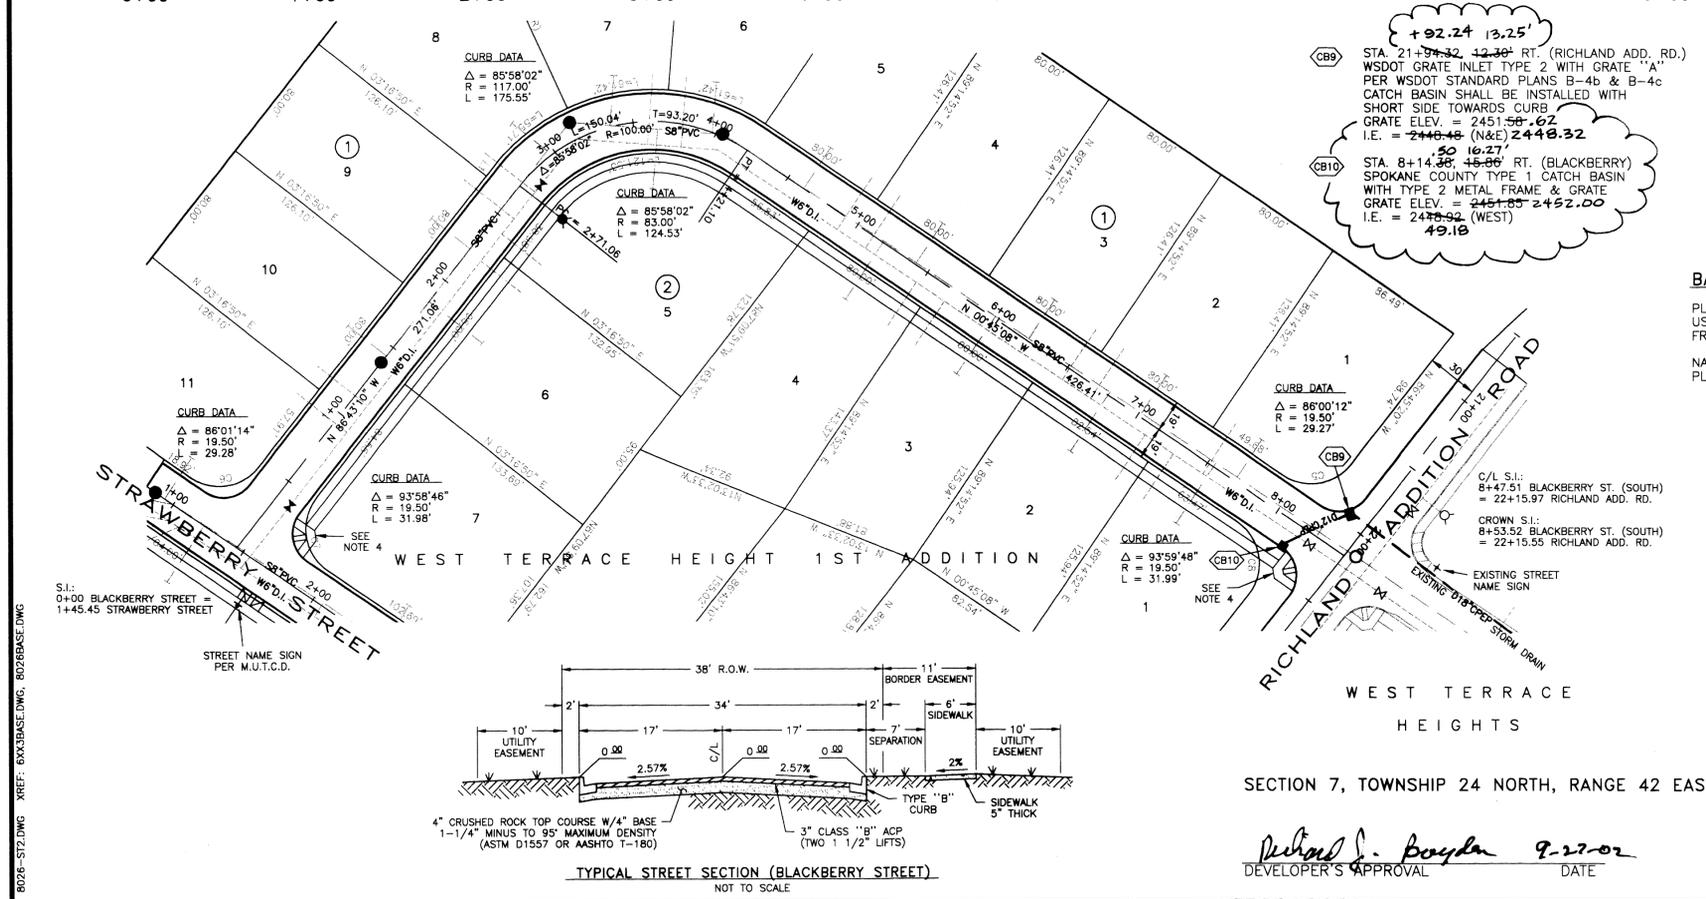


SPokane County Engineers Office
OFFICIAL PUBLIC DOCUMENT ORIGINAL
"AS-BUILTS"
CERTIFIED RECORD DRAWINGS
 PROJECT #: **P1818**
 DATE ACCEPTED: **12/10/04**

- CONSTRUCTION NOTES:**
- ALL ITEMS OF CONSTRUCTION SHALL BE COMPLETED IN ACCORDANCE WITH THE 2000 STANDARD SPECIFICATIONS FOR ROAD, BRIDGE, AND MUNICIPAL CONSTRUCTION AS PROMULGATED JOINTLY BY THE WASHINGTON STATE DEPARTMENT OF TRANSPORTATION (WSDOT) AND THE AMERICAN PUBLIC WORKS ASSOCIATION (APWA); THE 1995 SPOKANE COUNTY STANDARDS FOR ROAD AND SEWER CONSTRUCTION; AND ALL AMENDMENTS HERETO.
 - LOCATIONS OF EXISTING UTILITIES SHOWN IN THE PLANS ARE APPROXIMATE. PRIOR TO SITE CONSTRUCTION, THE CONTRACTOR SHALL BE RESPONSIBLE FOR LOCATING ALL UNDERGROUND UTILITIES. CALL THE UNDERGROUND UTILITY LOCATION SERVICE AT 456-8000 BEFORE YOU DIG. ANY CONFLICTING UTILITIES SHALL BE RELOCATED PRIOR TO CONSTRUCTION OF ROAD AND DRAINAGE FACILITIES.
 - CURB DATA INFORMATION IS FOR BACK OF CURB.
 - WHEELCHAIR RAMP DESIGN "B", PER SPOKANE COUNTY STANDARD PLAN A-5.
 - THE CONTRACTOR IS REQUIRED TO HAVE A COMPLETE SET OF THE APPROVED ROAD AND DRAINAGE PLANS ON THE JOB SITE WHENEVER CONSTRUCTION IS IN PROGRESS.
 - IF THE CONTRACTOR DISCOVERS ANY DISCREPANCIES BETWEEN THE PLANS AND EXISTING CONDITIONS ENCOUNTERED, THE CONTRACTOR SHALL IMMEDIATELY NOTIFY THE DESIGN ENGINEER AND THE SPOKANE COUNTY ENGINEER'S OFFICE.
 - FOR ANY CURB GRADES LESS THAN 0.8% (0.008 ft/ft), A WASHINGTON STATE-LICENSED PROFESSIONAL LAND SURVEYOR SHALL VERIFY THAT THE CURB FORMS ARE AT THE GRADES NOTED ON THE APPROVED PLANS, PRIOR TO PLACEMENT OF CURB MATERIAL. THE CONTRACTOR IS RESPONSIBLE FOR ARRANGING AND COORDINATING WORK WITH THE PROFESSIONAL LAND SURVEYOR.
 - ALL STORM DRAIN SHALL BE CPEP, ADS N-12 CORRUGATED PIPE.


BASIS OF ELEVATION
 PLAN DATUM:
 USCA&GS VERTICAL DATUM (1929)
 FROM USCA&GS BENCH MARK NO. 354
 NAV88 DATUM:
 PLAN DATUM + 3.80' = NAV88 DATUM

- LEGEND**
- PROPOSED SEWER MANHOLE
 - EXISTING SEWER MANHOLE
 - ⊕ PROPOSED FIRE HYDRANT
 - ⊕ EXISTING FIRE HYDRANT
 - ⊗ PROPOSED WATER GATE VALVE
 - ⊗ EXISTING WATER GATE VALVE
 - PROPOSED CATCH BASIN
 - D12" CPEP — PROPOSED STORM DRAIN, DIA. AS SHOWN
 - S8" PVC --- SANITARY SEWER, DIA. AS SHOWN
 - W6" D.I. --- D.I. WATER MAIN, DIA. AS SHOWN

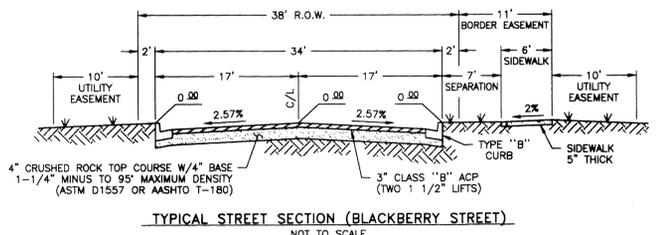

WEST TERRACE HEIGHTS
 SECTION 7, TOWNSHIP 24 NORTH, RANGE 42 EAST
 Richard J. Boyda 9-27-02
 DEVELOPER'S APPROVAL DATE


METRO ENGINEERING, INC.
 S. 324 SHERMAN
 SPOKANE, WA 99202
 (509) 624-9351

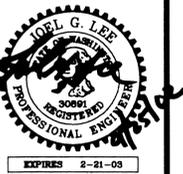


DRAWN BY: **JKO**
 CHECKED BY: **JGL**
 DATE: **09/24/02**
 SCALE: **AS SHOWN**

WEST TERRACE HEIGHTS 1st ADD.
BLACKBERRY STREET, Plan & Profile
Sta. 0+00.00 to Sta. 8+53.52

SHEET
3 OF 5
 98-026.2

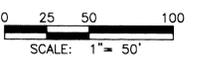

CALL BEFORE YOU DIG: 456-8000

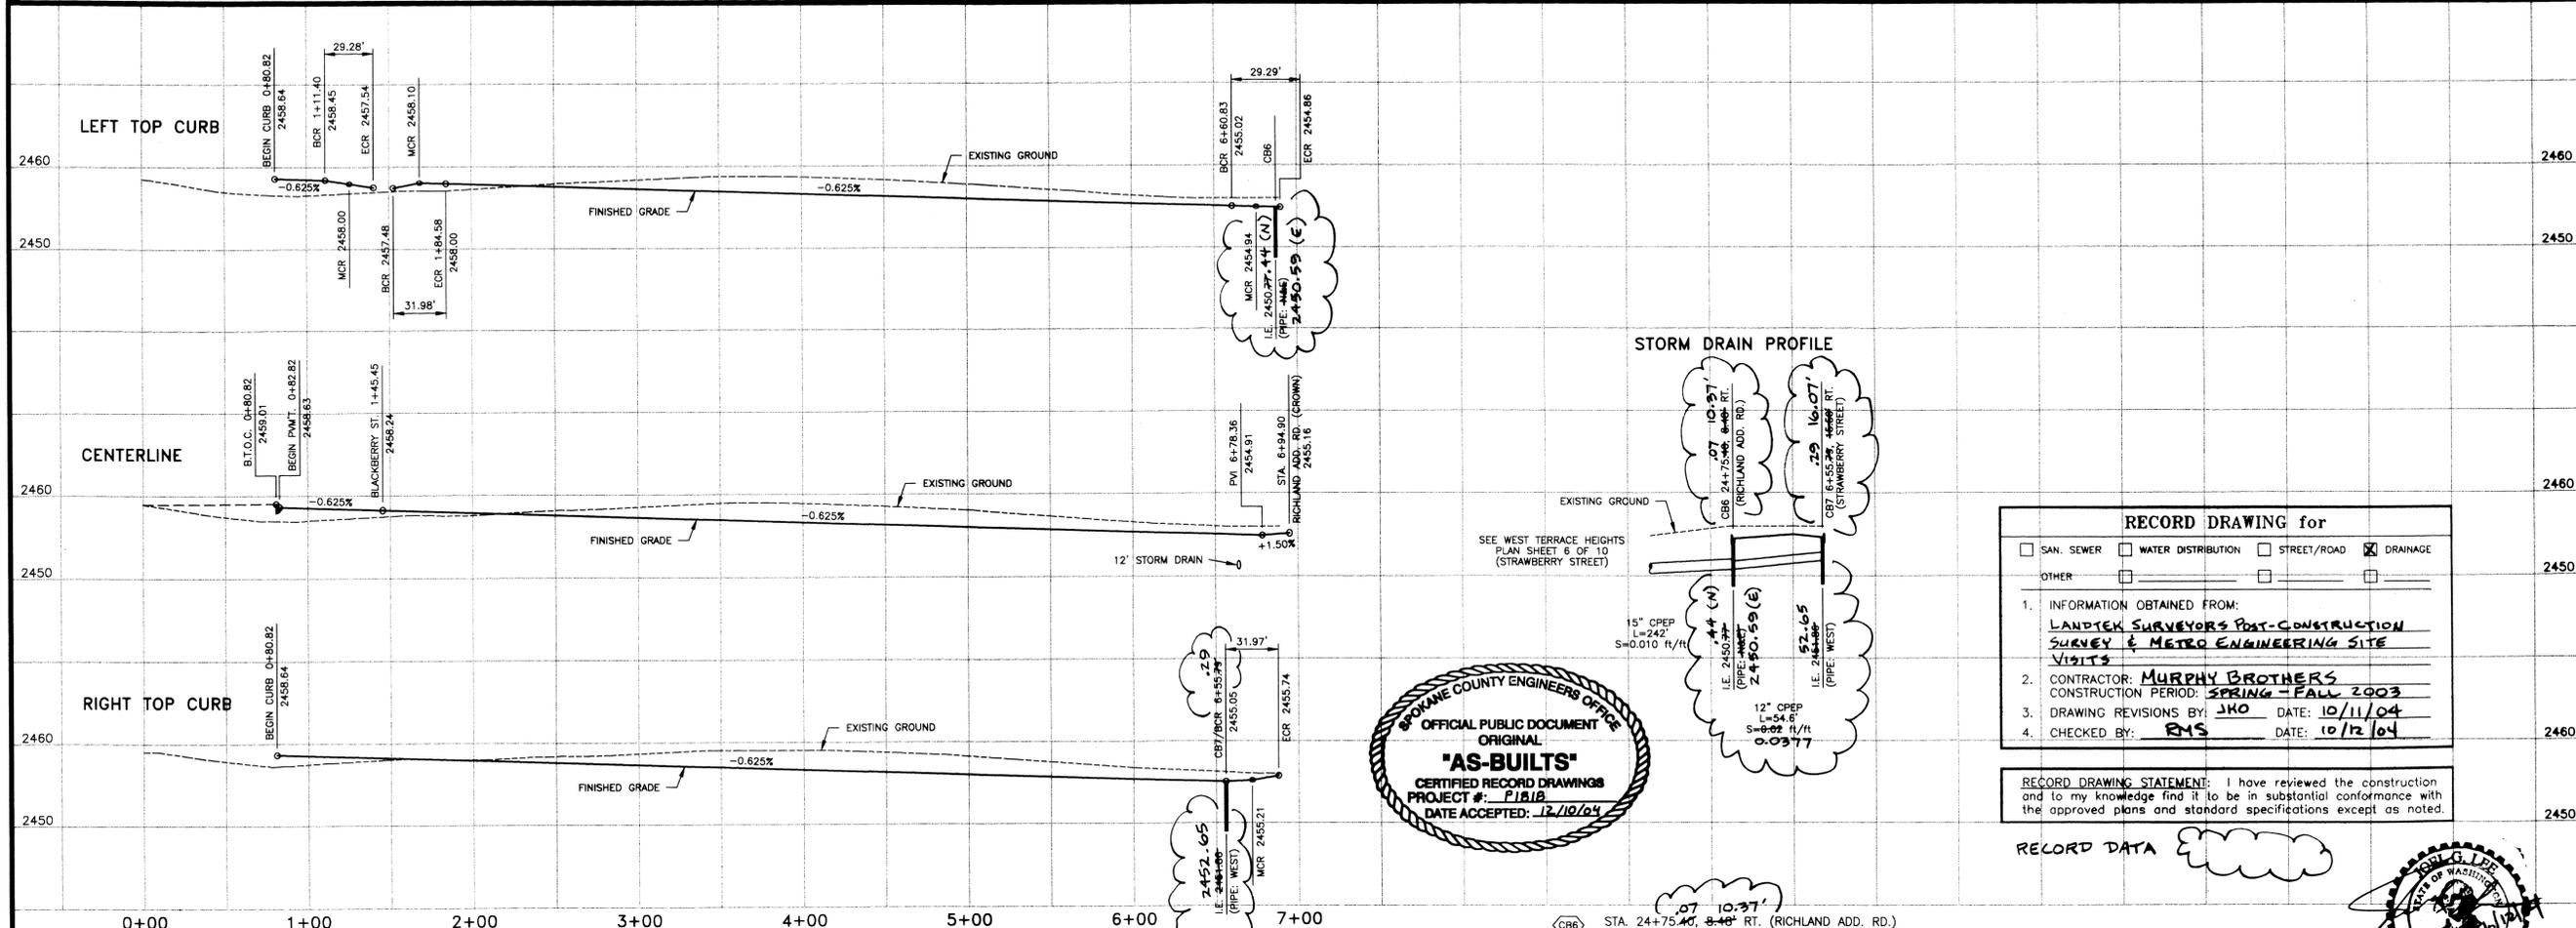

RECORD DRAWING for

SAN. SEWER WATER DISTRIBUTION STREET/ROAD DRAINAGE

OTHER:


1. INFORMATION OBTAINED FROM:
LANDTEK SURVEYORS POST-CONSTRUCTION SURVEY & METRO ENGINEERING SITE VISITS

2. CONTRACTOR: MURPHY BROTHERS
CONSTRUCTION PERIOD: SPRING - FALL 2003

3. DRAWING REVISIONS BY: JHO DATE: 10/11/04

4. CHECKED BY: RMS DATE: 10/12/04

RECORD DRAWING STATEMENT: I have reviewed the construction and to my knowledge find it to be in substantial conformance with the approved plans and standard specifications except as noted.

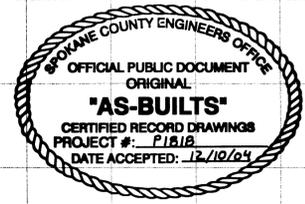

RECORD DATA



STA. 24+75.40, 8+48' RT. (RICHLAND ADD. RD.)
WSDOT GRATE INLET TYPE 2 WITH GRATE "A"
PER WSDOT STANDARD PLANS B-4b & B-4c
CATCH BASIN SHALL BE INSTALLED WITH SHORT SIDE TOWARDS CURB
GRATE ELEV. = 2454.38-34
I.E. = 2450.77 (N) 2450.44 (N) 2450.59 (E)

STA. 6+55.79, 15+86' RT. (STRAWBERRY)
SPOKANE COUNTY TYPE 1 CATCH BASIN WITH TYPE 2 METAL FRAME & GRATE
GRATE ELEV. = 2454.47-60
I.E. = 2451.86 (WEST) 52.65

ENGINEER'S STATEMENT:

THE DESIGN IMPROVEMENTS SHOWN IN THIS SET OF PLANS AND CALCULATIONS CONFORM TO THE APPLICABLE EDITIONS OF THE SPOKANE COUNTY STANDARDS FOR ROAD AND SEWER CONSTRUCTION AND THE SPOKANE COUNTY GUIDELINES FOR STORMWATER MANAGEMENT. ALL DESIGN DEVIATIONS HAVE BEEN APPROVED BY THE SPOKANE COUNTY ENGINEER. I APPROVE THESE PLANS FOR CONSTRUCTION.

- CONSTRUCTION NOTES:**
- ALL ITEMS OF CONSTRUCTION SHALL BE COMPLETED IN ACCORDANCE WITH THE 2000 STANDARD SPECIFICATIONS FOR ROAD, BRIDGE, AND MUNICIPAL CONSTRUCTION AS PROMULGATED JOINTLY BY THE WASHINGTON STATE DEPARTMENT OF TRANSPORTATION (WSDOT) AND THE AMERICAN PUBLIC WORKS ASSOCIATION (APWA); THE 1995 SPOKANE COUNTY STANDARDS FOR ROAD AND SEWER CONSTRUCTION; AND ALL AMENDMENTS HERETO.
 - LOCATIONS OF EXISTING UTILITIES SHOWN IN THE PLANS ARE APPROXIMATE. PRIOR TO SITE CONSTRUCTION, THE CONTRACTOR SHALL BE RESPONSIBLE FOR LOCATING ALL UNDERGROUND UTILITIES. CALL THE UNDERGROUND UTILITY LOCATION SERVICE AT 456-8000 BEFORE YOU DIG. ANY CONFLICTING UTILITIES SHALL BE RELOCATED PRIOR TO CONSTRUCTION OF ROAD AND DRAINAGE FACILITIES.
 - CURB DATA INFORMATION IS FOR BACK OF CURB.
 - WHEELCHAIR RAMP DESIGN "B", PER SPOKANE COUNTY STANDARD PLAN A-5.
 - THE CONTRACTOR IS REQUIRED TO HAVE A COMPLETE SET OF THE APPROVED ROAD AND DRAINAGE PLANS ON THE JOB SITE WHENEVER CONSTRUCTION IS IN PROGRESS.
 - IF THE CONTRACTOR DISCOVERS ANY DISCREPANCIES BETWEEN THE PLANS AND EXISTING CONDITIONS ENCOUNTERED, THE CONTRACTOR SHALL IMMEDIATELY NOTIFY THE DESIGN ENGINEER AND THE SPOKANE COUNTY ENGINEER'S OFFICE.
 - FOR ANY CURB GRADES LESS THAN 0.8% (0.008 ft/ft), A WASHINGTON STATE-LICENSED PROFESSIONAL LAND SURVEYOR SHALL VERIFY THAT THE CURB FORMS ARE AT THE GRADES NOTED ON THE APPROVED PLANS, PRIOR TO PLACEMENT OF CURB MATERIAL. THE CONTRACTOR IS RESPONSIBLE FOR ARRANGING AND COORDINATING WORK WITH THE PROFESSIONAL LAND SURVEYOR.
 - ALL STORM DRAIN SHALL BE CPEP, ADS N-12 CORRUGATED PIPE.

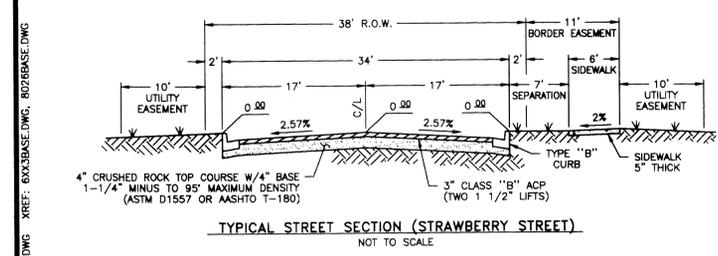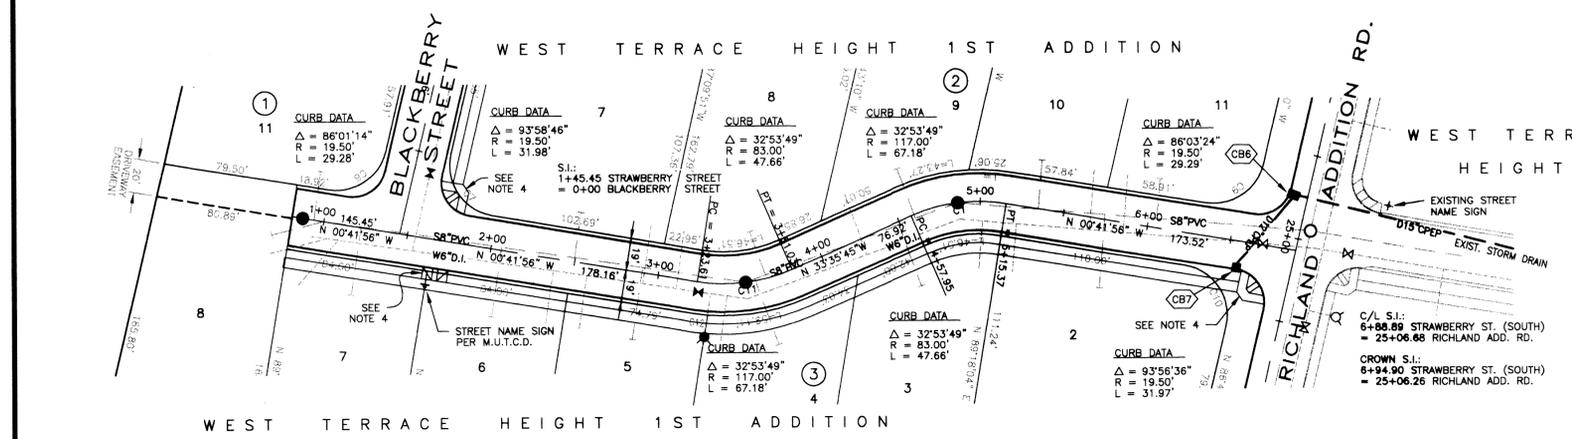

- LEGEND**
- PROPOSED SEWER MANHOLE
 - EXISTING SEWER MANHOLE
 - ⊕ PROPOSED FIRE HYDRANT
 - ⊖ EXISTING FIRE HYDRANT
 - ⊗ PROPOSED WATER GATE VALVE
 - ⊘ EXISTING WATER GATE VALVE
 - PROPOSED CATCH BASIN
 - PROPOSED STORM DRAIN, DIA. AS SHOWN
 - S8\"/>

BASIS OF ELEVATION

PLAN DATUM:
USC&GS VERTICAL DATUM (1929)
FROM USCA&GS BENCH MARK NO. 354

NAV88 DATUM:
PLAN DATUM + 3.80' = NAV88 DATUM

Richard J. Boylen 9-27-02
DEVELOPER'S APPROVAL DATE

SECTION 7, TOWNSHIP 24 NORTH, RANGE 42 EAST

METRO ENGINEERING, INC.
S. 324 SHERMAN
SPOKANE, WA 99202
(509) 624-9351



DRAWN BY: JHO
CHECKED BY: JGL
DATE: 09/24/02
SCALE: AS SHOWN

WEST TERRACE HEIGHTS 1st ADD.
STRAWBERRY STREET, Plan & Profile
Sta. 0+80.82 to Sta. 6+94.90

SHEET
4 OF 5
98-026.2

CALL BEFORE YOU DIG: 456-8000

P-1818 Eng As-Built

RECORD DRAWING for

SAN. SEWER WATER DISTRIBUTION STREET/ROAD DRAINAGE

OTHER

1. INFORMATION OBTAINED FROM:
LANDTEK SURVEYORS POST-CONSTRUCTION SURVEY & METRO ENGINEERING SITE VISITS

2. CONTRACTOR: MURPHY BROTHERS
CONSTRUCTION PERIOD: SPRING-FALL 2003

3. DRAWING REVISIONS BY: SKO DATE: 10/11/04

4. CHECKED BY: RMS DATE: 10/12/04

RECORD DRAWING STATEMENT: I have reviewed the construction and to my knowledge find it to be in substantial conformance with the approved plans and standard specifications except as noted.



II-5.4.3 BMP E1.35: PERMANENT SEEDING AND PLANTING

CODE: PS SYMBOL: ← PS →

DEFINITION:
THE ESTABLISHMENT OF PERENNIAL VEGETATIVE COVER ON DISTURBED AREAS.

PURPOSE:
TO ESTABLISH PERENNIAL VEGETATION (SUCH AS GRASSES, LEGUMES AND TREES OR SHRUBS) AS RAPIDLY AS POSSIBLE TO PREVENT SOIL EROSION BY WIND OR WATER, AND TO IMPROVE WILDLIFE HABITAT AND SITE AESTHETICS.

TO PROVIDE POLLUTANT FILTRATION (BIOFILTRATION) IN VEGETATION-LINED CHANNELS AND TO ESTABLISH CONSTRUCTED WETLANDS AS REQUIRED (SEE BMP RW.10 IN CHAPTER III-4 AND RV.05 IN CHAPTER III-6).

CONDITIONS WHERE PRACTICE APPLIES:

- GRADED, FINAL GRADED OR CLEARED AREAS WHERE PERMANENT VEGETATIVE COVER IS NEEDED TO STABILIZE THE SOIL.
- AREAS WHICH WILL NOT BE BROUGHT TO FINAL GRADE FOR A YEAR OR MORE.
- VEGETATION-LINED CHANNELS.
- RETENTION OR DETENTION PONDS AS REQUIRED.

GRASS SEED:
PROVIDE FRESH, CLEAN, NEW-CROP SEED COMPLYING WITH TOLERANCE FOR PURITY AND GERMINATION ESTABLISHED BY THE OFFICIAL SEED ANALYSIS OF NORTH AMERICA. PROVIDE SEED MIXTURE COMPOSED OF GRASS SPECIES AND PERCENTAGES BY WEIGHT AS FOLLOWS:

20% ELKA PERENNIAL RYE 20% DURAR HARD FESCUE
45% COVAR SHEEP FESCUE 15% RUEBENS CANADIAN BLUEGRASS

PROVIDE MIXTURE COMPOSED OF GRASS SEED AND FERTILIZER IN PERCENTAGES AS FOLLOWS:

GRASS SEED: 90 LBS. PER ACRE
FERTILIZER: 16-16-16 TIMED RELEASE COMPOSITION, 300 LBS. PER ACRE

ALL SEEDING SHALL BE DONE IN ACCORDANCE WITH THE WSDOT 2000 STANDARD SPECIFICATIONS, SECTION 8-01. THE SEEDING DATES ALLOWED IN SECTION 8-01.3(7) SHALL BE AMENDED TO INCLUDE MARCH 1 TO MAY 15. CONTRACTOR TO IRRIGATE SEEDED AREAS UNTIL SEED HAS GERMINATED.

EROSION & SEDIMENT CONTROL NOTES:

- 1) EROSION/SEDIMENT CONTROL (ESC) HAS BEEN REQUIRED FOR THIS PROJECT. IMPLEMENTATION OF THE ESC PLAN, CONSTRUCTION, MAINTENANCE, AND UPGRADING OF THE FACILITIES ARE THE RESPONSIBILITY OF THE DEVELOPER/CONTRACTOR UNTIL ALL CONSTRUCTION IS COMPLETED AND ACCEPTED BY SPOKANE COUNTY, OR UNTIL VEGETATION IS ESTABLISHED THROUGHOUT THE SITE, AND ACCEPTED BY SPOKANE COUNTY, WHICHEVER IS LATER.
- 2) THE CONTRACTOR SHALL MAINTAIN THE ESC FACILITIES DURING WET WEATHER CONDITIONS TO ASSURE THAT THE FACILITIES ARE WORKING AS PLANNED AND THAT EROSION OF SOILS IS MINIMIZED. THE CONTRACTOR SHALL USE MEASURES AS NECESSARY DURING WET WEATHER CONDITIONS TO MINIMIZE TRACKING OF SOILS ONTO EXISTING STREETS. THE ESC MEASURES SHOWN ARE THE MINIMUM REQUIREMENTS FOR THE ANTICIPATED SITE CONDITIONS. THE CONTRACTOR SHALL INSPECT AND MAINTAIN THESE ESC MEASURES DAILY, AND SHALL MAINTAIN AND UPGRADE THESE MEASURES AS NECESSARY TO PREVENT SEDIMENT-LOADED WATER FROM EITHER FLOWING OFF THE SITE, OR INTO NEW/EXISTING STORM DRAINAGE FACILITIES.
- 3) THE EROSION CONTROL PLANS AND SPECIFICATIONS ARE SCHEMATIC AND ARE NOT INTENDED TO DEPICT ALL DETAILS OF THE WORK REQUIRED. THE CONTRACTOR SHALL BE RESPONSIBLE TO FAMILIARIZE HIMSELF WITH THE ACTUAL SITE CONDITIONS AND FACTORS WHICH MAY CONTRIBUTE TO SOIL EROSION. THE CONTRACTOR SHALL IMPLEMENT ANY ADDITIONAL MEASURES WHICH ARE NECESSARY TO ALLEVIATE THE POTENTIAL FOR SOIL EROSION.
- 4) APPROVAL OF THE ESC PLAN DOES NOT CONSTITUTE APPROVAL OF ANY OF THE PROPOSED STORM DRAINAGE, GRADING OR UTILITY DESIGN ELEMENTS SHOWN ON THE ESC PLAN.
- 5) THE CONTRACTOR/DEVELOPER IS RESPONSIBLE FOR INSTALLING ROCK CONSTRUCTION ENTRIES (SEE DETAIL) AT ANY AND ALL LOCATIONS USED TO ENTER OR EXIT THE PROJECT SITE.

PROJECT DATA NOTES:

NAME OF PROPERTY OWNER:
J & D BUILDERS, INC.
(RICH BOYDEN)
1429 BROADWAY
EVERETT, WA 98201 T: (425) 252-1162

NAME OF PERMIT APPLICANT:
J & D BUILDERS, INC.
(RICH BOYDEN)
1429 BROADWAY
EVERETT, WA 98201 T: (425) 252-1162

NAME OF CONTACT PERSON AT PROJECT SITE:
MURPHY BROTHERS
TIM HURLEY
P.O. BOX 2885
E. 3812 BROADWAY AVENUE
SPOKANE, WA 99220 T: (509) 535-1591

PROJECT ADDRESS:
THE SITE IS LOCATED IN THE WEST PLAINS AREA OFF OF HAYFORD ROAD ON THE 10200 BLOCK OF RICHLAND ADDITION ROAD.

NAME OF PLAN PREPARER:
METRO ENGINEERING, INC.
324 S. SHERMAN
SPOKANE, WA 99202 T: (509) 624-9351


DESCRIPTION OF PROJECT:
WEST TERRACE HEIGHTS 1ST ADDITION IS A 30 LOT PLAT LOCATED SOUTH OF WEST TERRACE HEIGHTS, ACROSS RICHLAND ADDITION ROAD. THE PLAT IS APPROXIMATELY 10 ACRES. WEST TERRACE HEIGHTS 1ST ADDITION IS AN APPROVED PRELIMINARY PLAT.

DESCRIPTION OF EXISTING VEGETATION & SOIL INFORMATION:
THE SITE CONSISTS OF MOSTLY ALFALFA/HAY FIELD LOCATED ON CHENEY SOIL AND A SMALL PORTION OF DRAINED COCOLALLA SOIL ON THE WESTERN PORTION OF THE SITE.

LEGAL DESCRIPTION:

LOTS 16 AND 17, RICHLAND ADDITION PLAT THEREOF RECORDED IN VOLUME 100 OF THE SPOKANE COUNTY RECORDS, QUARTER 7, SECTION 7, TOWNSHIP 24 NORTH, RANGE 42 EAST, W.M., COUNTY OF SPOKANE, STATE OF WASHINGTON.

ENGINEER'S STATEMENT:
THE DESIGN IMPROVEMENTS SHOWN IN THIS SET OF PLANS AND CALCULATIONS CONFORM TO THE APPLICABLE EDITIONS OF THE SPOKANE COUNTY STANDARDS FOR ROAD AND SEWER CONSTRUCTION AND THE SPOKANE COUNTY GUIDELINES FOR STORMWATER MANAGEMENT. ALL DESIGN DEVIATIONS HAVE BEEN APPROVED BY THE SPOKANE COUNTY ENGINEER. I APPROVE THESE PLANS FOR CONSTRUCTION.

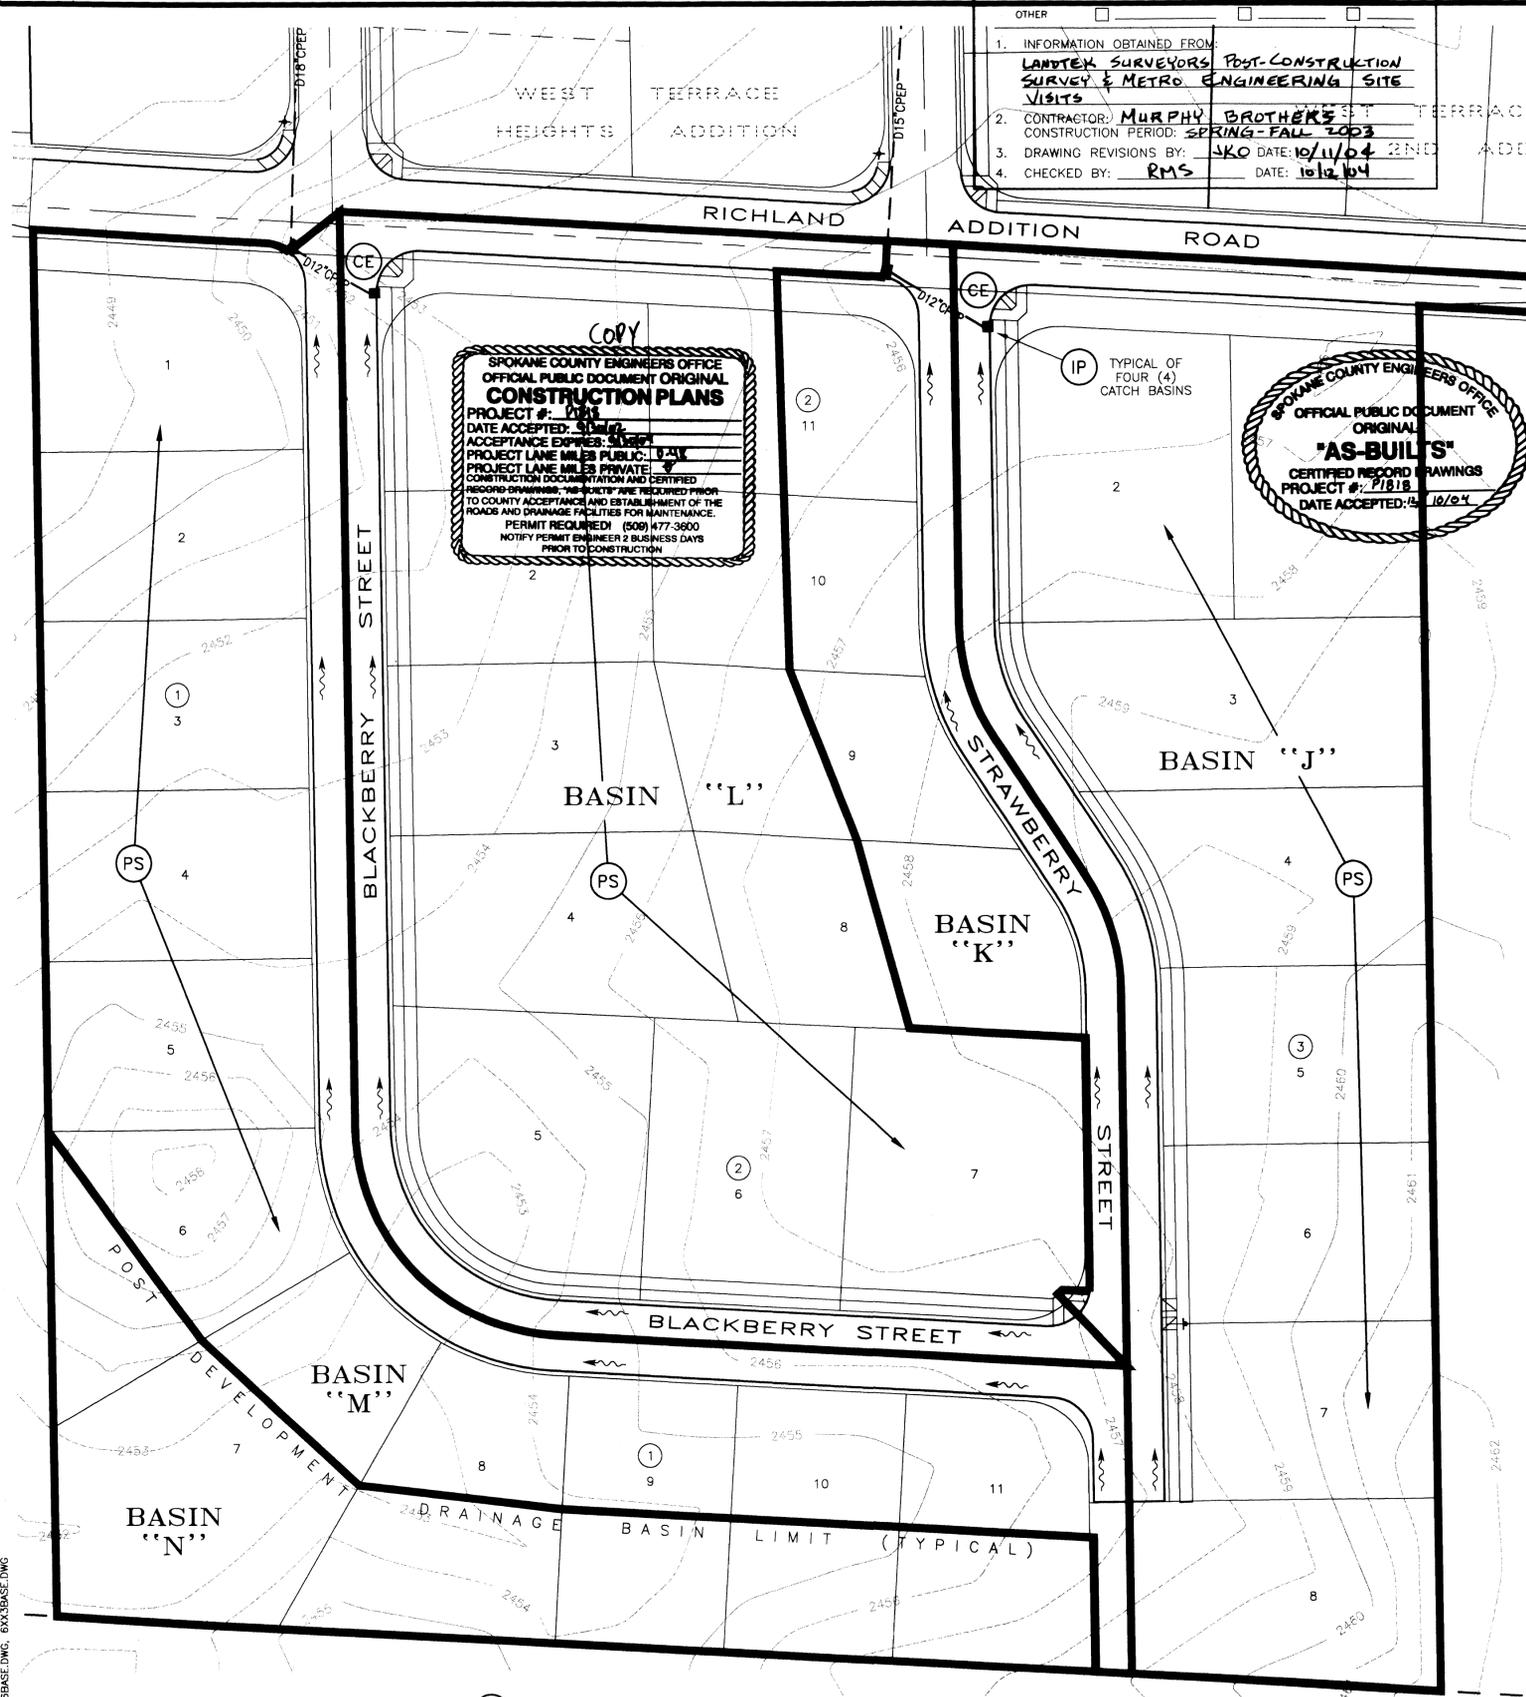


SPokane County Engineers Office
OFFICIAL PUBLIC DOCUMENT ORIGINAL CONSTRUCTION PLANS

PROJECT #: 1818
DATE ACCEPTED: 10/12/04
ACCEPTANCE EXPIRES: 10/12/05
PROJECT NAME: WEST TERRACE HEIGHTS 1ST ADDITION
PROJECT LANE MILES: PRIVATE
CONSTRUCTION DOCUMENTATION AND CERTIFIED RECORD DRAWINGS. THE "AS-BUILT" ARE REQUIRED PRIOR TO COUNTY ACCEPTANCE AND ESTABLISHMENT OF THE ROADS AND DRAINAGE FACILITIES FOR MAINTENANCE.
PERMIT REQUIRED! (509) 477-3600
NOTIFY PERMIT ENGINEER 2 BUSINESS DAYS PRIOR TO CONSTRUCTION.

SPokane County Engineers Office
OFFICIAL PUBLIC DOCUMENT ORIGINAL "AS-BUILTS"

CERTIFIED RECORD DRAWINGS
PROJECT #: 1818
DATE ACCEPTED: 10/12/04

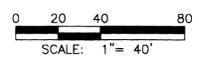

PERMANENT SEEDING PS

INLET PROTECTION IP

STABILIZED CONSTRUCTION ENTRANCE AND TIRE WASH CE

INLET PROTECTION IP

STABILIZED CONSTRUCTION ENTRANCE AND TIRE WASH CE

INLET PROTECTION IP

STABILIZED CONSTRUCTION ENTRANCE AND TIRE WASH CE

INLET PROTECTION IP


STABILIZED CONSTRUCTION ENTRANCE AND TIRE WASH CE

INLET PROTECTION IP

STABILIZED CONSTRUCTION ENTRANCE AND TIRE WASH CE

INLET PROTECTION IP

STABILIZED CONSTRUCTION ENTRANCE AND TIRE WASH CE

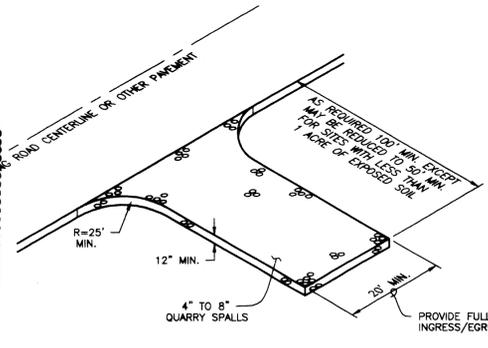

SPokane County Engineers Office
OFFICIAL PUBLIC DOCUMENT ORIGINAL CONSTRUCTION PLANS

PROJECT #: 1818
DATE ACCEPTED: 10/12/04
ACCEPTANCE EXPIRES: 10/12/05
PROJECT NAME: WEST TERRACE HEIGHTS 1ST ADDITION
PROJECT LANE MILES: PRIVATE
CONSTRUCTION DOCUMENTATION AND CERTIFIED RECORD DRAWINGS. THE "AS-BUILT" ARE REQUIRED PRIOR TO COUNTY ACCEPTANCE AND ESTABLISHMENT OF THE ROADS AND DRAINAGE FACILITIES FOR MAINTENANCE.
PERMIT REQUIRED! (509) 477-3600
NOTIFY PERMIT ENGINEER 2 BUSINESS DAYS PRIOR TO CONSTRUCTION.

LEGEND

--- 2453 --- EXISTING CONTOUR, 1' CONTOUR
--- 2455 --- EXISTING CONTOUR, 5' CONTOUR


⊙ CE CONSTRUCTION ENTRANCE
⊙ PS PERMANENT SEEDING
⊙ IP INLET PROTECTION

PREPARER'S STATEMENT:
THIS EROSION CONTROL PLAN MEETS THE ESC PLAN REQUIREMENTS AS LISTED IN CHAPTER 4.5 OF THE SPOKANE COUNTY GUIDELINES FOR STORMWATER MANAGEMENT.

Richard J. Boyden 9-22-02
DEVELOPER'S APPROVAL DATE

SECTION 7, TOWNSHIP 24 NORTH, RANGE 42 EAST

METRO ENGINEERING, INC.
S. 324 SHERMAN
SPOKANE, WA 99202
(509) 624-9351

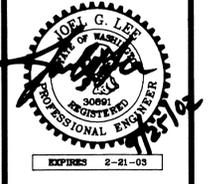

DRAWN BY: JKD
CHECKED BY: JCL
DATE: 09/24/02
SCALE: AS SHOWN

WEST TERRACE HEIGHTS 1ST ADDITION OVERALL DRAINAGE AND EROSION CONTROL PLAN

SHEET
5 OF 5
98-026.2

CALL BEFORE YOU DIG: 456-8000

P-1818 Eng As-Built