

# BLUE FOX — WOODLAND ESTATES PUD

## STREET AND DRAINAGE PLANS

NE 1/4 SECTION 31, T.26 N., R44 E., W.M.  
SPOKANE COUNTY, WASHINGTON


# RECORD DRAWING

### GENERAL NOTES PART 1

- ALL MATERIALS, WORKMANSHIP, AND CONSTRUCTION OF SITE IMPROVEMENTS SHALL MEET OR EXCEED SITE WORK STANDARDS AND THE STANDARDS AND SPECIFICATIONS SET FORTH IN SPOKANE COUNTY REGULATIONS AND APPLICABLE STATE AND FEDERAL REGULATIONS. WHERE THERE IS CONFLICT BETWEEN THESE PLANS AND THE SPECIFICATIONS, OR ANY APPLICABLE STANDARDS, THE HIGHER QUALITY STANDARD SHALL APPLY. ALL WORK WITHIN PUBLIC R.O.W. OR EASEMENTS SHALL BE INSPECTED AND APPROVED BY THE SPOKANE COUNTY INSPECTOR. INSPECTION SERVICES AND CONSTRUCTION CERTIFICATION TO BE PROVIDED BY ENGINEER OF RECORD.
- THE CONTRACTOR IS SPECIFICALLY CAUTIONED THAT THE LOCATION AND/OR ELEVATION OF EXISTING UTILITIES, AS SHOWN ON THESE PLANS, IS BASED ON RECORDS OF THE VARIOUS UTILITY COMPANIES AND, WHERE POSSIBLE, MEASUREMENTS TAKEN IN THE FIELD. THE INFORMATION IS NOT TO BE RELIED UPON AS BEING EXACT OR COMPLETE. THE CONTRACTOR MUST CALL THE LOCAL UTILITY LOCATION CENTER AT LEAST 48 HOURS BEFORE ANY EXCAVATION TO REQUEST EXACT FIELD LOCATIONS OF THE UTILITIES. PRIOR TO CONSTRUCTION, THE CONTRACTOR SHALL VERIFY PERTINENT LOCATIONS AND ELEVATIONS, ESPECIALLY AT THE CONNECTION POINTS AND AT POTENTIAL UTILITY CONFLICTS. IT SHALL BE THE RESPONSIBILITY OF THE CONTRACTOR TO RELOCATE ALL EXISTING UTILITIES THAT CONFLICT WITH THE PROPOSED IMPROVEMENTS SHOWN ON THESE PLANS.
- THE CONTRACTOR SHALL BE RESPONSIBLE FOR OBTAINING ALL NECESSARY PERMITS FROM ALL APPLICABLE AGENCIES. THE CONTRACTOR SHALL NOTIFY THE SPOKANE COUNTY INSPECTOR AT LEAST 48 HOURS PRIOR TO THE START OF ANY EARTH DISTURBING ACTIVITY, OR CONSTRUCTION ON ANY AND ALL PUBLIC IMPROVEMENTS.
- THE CONTRACTOR SHALL COORDINATE AND COOPERATE WITH THE SPOKANE COUNTY AND ALL UTILITY COMPANIES INVOLVED WITH REGARD TO RELOCATIONS OR ADJUSTMENTS OF EXISTING UTILITIES DURING CONSTRUCTION AND TO ASSURE THAT THE WORK IS ACCOMPLISHED IN A TIMELY FASHION AND WITH A MINIMUM DISRUPTION OF SERVICE. THE CONTRACTOR SHALL BE RESPONSIBLE FOR CONTACTING ALL PARTIES AFFECTED BY ANY DISRUPTION OF ANY UTILITY SERVICE.
- THE CONTRACTOR SHALL HAVE ONE (1) SIGNED COPY OF THE APPROVED PLANS, ONE (1) COPY OF THE APPROPRIATE STANDARDS AND SPECIFICATIONS, AND A COPY OF ANY PERMITS AND EXTENSION AGREEMENTS NEEDED FOR THE JOB, ON-SITE AT ALL TIMES.
- THE CONTRACTOR SHALL BE RESPONSIBLE FOR ALL ASPECTS OF SAFETY INCLUDING, BUT NOT LIMITED TO, EXCAVATION, TRENCHING, SHORING, TRAFFIC CONTROL, AND SECURITY.
- IF, DURING THE CONSTRUCTION PROCESS, CONDITIONS ARE ENCOUNTERED BY THE CONTRACTOR, HIS SUBCONTRACTORS, OR OTHER AFFECTED PARTIES, WHICH COULD INDICATE A SITUATION THAT IS NOT IDENTIFIED IN THE PLANS OR SPECIFICATIONS, THE CONTRACTOR SHALL CONTACT THE ENGINEER IMMEDIATELY.
- ALL REFERENCES TO ANY PUBLISHED STANDARDS SHALL REFER TO THE LATEST REVISION OF SAID STANDARD, UNLESS SPECIFICALLY STATED OTHERWISE.
- THE CONTRACTOR SHALL SUBMIT A TRAFFIC CONTROL PLAN, IN ACCORDANCE WITH M.U.T.C.D. TO THE APPROPRIATE RIGHT-OF-WAY AUTHORITY SPOKANE COUNTY, FOR APPROVAL PRIOR TO ANY CONSTRUCTION ACTIVITIES WITHIN, OR AFFECTING, THE RIGHT-OF-WAY. THE CONTRACTOR SHALL BE RESPONSIBLE FOR PROVIDING ANY AND ALL TRAFFIC CONTROL DEVICES AS MAY BE REQUIRED BY THE CONSTRUCTION ACTIVITIES.
- THE CONTRACTOR IS RESPONSIBLE FOR PROVIDING ALL LABOR AND MATERIALS NECESSARY FOR THE COMPLETION OF THE INTENDED IMPROVEMENTS SHOWN ON THESE DRAWINGS OR DESIGNATED TO BE PROVIDED, INSTALLED, CONSTRUCTED, REMOVED AND RELOCATED UNLESS SPECIFICALLY NOTED OTHERWISE.
- THE CONTRACTOR SHALL BE RESPONSIBLE FOR KEEPING ROADWAYS FREE AND CLEAR OF ALL CONSTRUCTION DEBRIS AND DIRT TRACKED FROM THE SITE.
- THE CONTRACTOR SHALL BE RESPONSIBLE FOR RECORDING RECORD INFORMATION ON A SET OF RECORD DRAWINGS KEPT AT THE CONSTRUCTION SITE, AND AVAILABLE TO THE SPOKANE COUNTY INSPECTOR AT ALL TIMES.
- DIMENSIONS FOR LAYOUT AND CONSTRUCTION ARE NOT TO BE SCALED FROM ANY DRAWING. IF PERTINENT DIMENSIONS ARE NOT SHOWN, CONTACT THE CONSULTANT ENGINEER FOR CLARIFICATION, AND ANNOTATE THE DIMENSION ON THE RECORD DRAWINGS.
- ALL STRUCTURAL EROSION CONTROL MEASURES SHALL BE INSTALLED, AT THE LIMITS OF CONSTRUCTION, PRIOR TO ANY OTHER GROUND-DISTURBING ACTIVITY. ALL EROSION CONTROL MEASURES SHALL BE MAINTAINED IN GOOD REPAIR BY THE CONTRACTOR, UNTIL SUCH TIME AS THE ENTIRE DISTURBED AREAS ARE STABILIZED WITH HARD SURFACE OR LANDSCAPING.
- THE CONTRACTOR SHALL SEQUENCE INSTALLATION OF UTILITIES IN SUCH A MANNER AS TO MINIMIZE POTENTIAL UTILITY CONFLICTS. IN GENERAL, STORM SEWER AND SANITARY SEWER SHOULD BE CONSTRUCTED PRIOR TO INSTALLATION OF WATER LINES AND DRY UTILITIES.
- ALL WORK WITHIN THE PUBLIC RIGHT-OF-WAY IS SUBJECT TO THE JURISDICTION OF THE SPOKANE COUNTY ENGINEERING DEPARTMENT STANDARD DETAILS AND SPECIFICATIONS.
- THE CONTRACTOR SHALL SUBMIT A PHASING PLAN FOR ALL WORK IN PUBLIC ROADS AND R.O.W.'S TO THE SPOKANE COUNTY BEFORE BEGINNING ANY WORK ON THESE ROADS. CONTRACTOR SHALL BEGIN WORK ONLY AFTER THE SPOKANE COUNTY APPROVES THE PHASING PLAN, AND A PRECONSTRUCTION MEETING IS HELD BETWEEN THE SPOKANE COUNTY THE ENGINEER AND THE CONTRACTOR.
- ALL OPERATIONS CONDUCTED ON THE PREMISES, INCLUDING THE WARMING UP, REPAIR, ARRIVAL, DEPARTURE OR RUNNING OF TRUCKS, EARTH MOVING EQUIPMENT, CONSTRUCTION EQUIPMENT AND ANY OTHER ASSOCIATED EQUIPMENT SHALL GENERALLY BE LIMITED TO THE PERIOD BETWEEN 6:00 A.M. AND 10:00 P.M. EVERYDAY UNLESS OTHERWISE APPROVED BY THE SPOKANE COUNTY.
- BASED ON A REQUIREMENT FROM A LOCAL JURISDICTION THE ENGINEER OR HIS DESIGNEE SHALL PERFORM MATERIALS TESTING AND QUALITY CONTROL ON THE PROJECT AND SHALL SUBMIT COPIES OF DAILY REPORTS, TEST REPORTS, PROJECT CERTIFICATION AND RECORD DRAWINGS TO THE SPOKANE COUNTY ENGINEER.
- NO REVISIONS SHALL BE MADE TO THESE PLANS WITHOUT THE APPROVAL OF THE SPOKANE COUNTY ENGINEER AND NOTIFICATION OF THE ENGINEER OF RECORD.
- IT IS THE RESPONSIBILITY OF THE CONTRACTOR TO COORDINATE ALL UTILITY RELOCATIONS CONSISTENT WITH THE CONTRACTORS SCHEDULE FOR THIS PROJECT, WHETHER SHOWN OR NOT SHOWN, AS IT RELATES TO THE CONSTRUCTION ACTIVITIES CONTEMPLATED IN THESE PLANS.

THE DESIGN IMPROVEMENTS SHOWN IN THIS SET OF PLANS AND CALCULATIONS CONFORM TO APPLICABLE EDITIONS OF THE SPOKANE COUNTY STANDARDS FOR ROAD AND SEWER CONSTRUCTION AND THE SPOKANE COUNTY GUIDELINES FOR STORM WATER MANAGEMENT. ALL DESIGN DEVIATIONS HAVE BEEN APPROVED BY THE SPOKANE COUNTY ENGINEER. I APPROVE THESE PLANS FOR CONSTRUCTION.

NAV D 88 DATUM  
ESTABLISHED ON-SITE BY GPS  
SURVEY PERFORMED 11/21/00  
BASED ON WSDOT MONUMENTS  
GP32290-143 AND GP33290-147

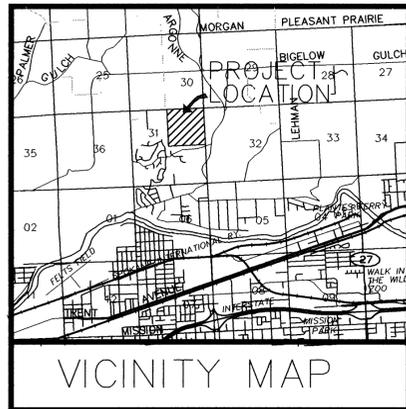

I have reviewed the construction and to my knowledge find it to be in substantial conformance with the approved certified plans and Standard Specifications except as noted.



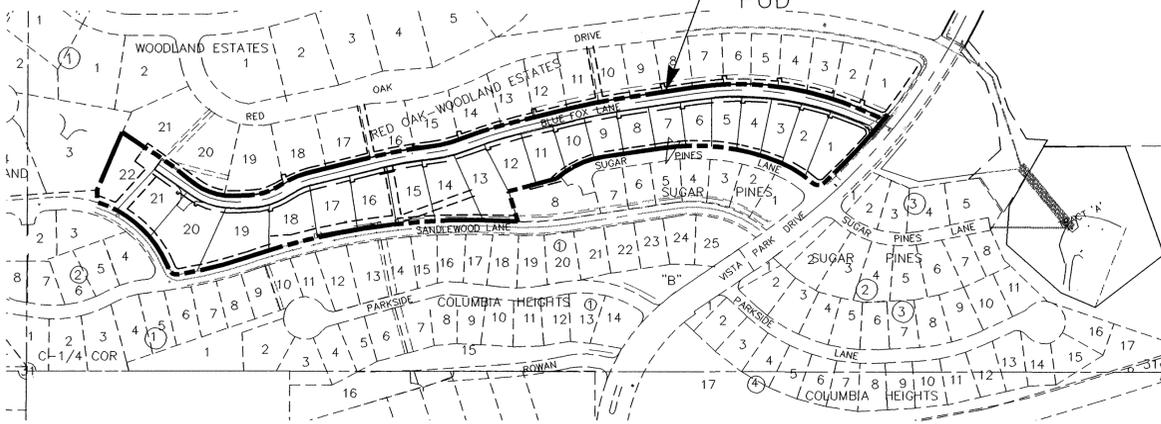


TABLE OF CONTENTS	
COVER SHEET	SHEET 1
BLUE FOX (STA 1+00 TO 10+50)	SHEET 2
BLUE FOX (STA 10+50 TO 18+83.18)	SHEET 3
STREET AND DRAINAGE DETAILS	SHEET 4
DRAINAGE DETAILS	SHEET 5
DRAINAGE AND POND DETAILS	SHEET 6
DRAINAGE DETAILS	SHEET 7
*DRAINAGE AND POND DETAILS-CONTINGENCY PLAN	SHEET 6A
*DRAINAGE DETAILS-CONTINGENCY PLAN	SHEET 7A
*RETAINING WALL-CONTINGENCY PLAN	SHEET 8
EROSION CONTROL COVER	SHEET 9
EROSION & SEDIMENT CONTROL PLAN	SHEET 10
RED OAK FINAL PLAT STREET PLAN (FOR REFERENCE ONLY)	

\*SHEETS ARE NOT FOR INITIAL CONSTRUCTION

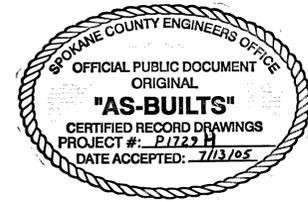

DEVELOPER'S APPROVAL \_\_\_\_\_ DATE \_\_\_\_\_

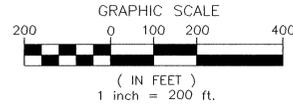

EXISTING	GENERAL	PROPOSED
---	ROADWAY CENTER LINE	---
---	RIGHT OF WAY LINE	---
---	PROPERTY LINE	---
---	EASEMENT LINE	---
---	CURB	---
---	PAVEMENT	---
---	PLAT BOUNDARY	---
---	STORM DRAINAGE	---
DW (---)	DRAINAGE LINE	DW (---)
CB (---)	DRYWELL	CB (---)
---	CATCH BASIN	---
---	DITCH	---
---	SANITARY SEWER	---
---	SANITARY SEWER MANHOLE	---
---	CLEANOUT	---
---	SEWER SERVICE	---
---	WATER	---
---	WATER LINE	---
---	VALVE	---
FH (---)	FIRE HYDRANT	FH (---)
WS (---)	SERVICE	WS (---)
---	BLOWOFF	---

### GENERAL NOTES PART 2

- ALL WORK AND MATERIALS SHALL BE IN CONFORMANCE WITH THE "SPOKANE COUNTY STANDARDS FOR ROAD AND SEWER CONSTRUCTION 1999", AND AS AMENDED.
- THE CONTRACTOR IS REQUIRED TO HAVE A VALID CONSTRUCTION PERMIT ON SITE AT ALL TIMES. THE ABSENCE OF THE PERMIT WILL RESULT IN AN IMMEDIATE SHUTDOWN OF WORK AND THE POSSIBLE REMOVAL OF THOSE ITEMS CONSTRUCTED WITHOUT THE PERMIT.
- THE CONTRACTOR IS REQUIRED TO HAVE A COMPLETE SET OF THE ACCEPTED ROAD AND DRAINAGE PLANS ON THE JOB SITE WHENEVER CONSTRUCTION IS IN PROGRESS.
- LOCATIONS OF EXISTING UTILITIES SHOWN IN THE PLANS ARE APPROXIMATE. THE CONTRACTOR SHALL BE RESPONSIBLE FOR LOCATING ALL UNDERGROUND UTILITIES. ANY CONFLICTING UTILITIES SHALL BE RELOCATED PRIOR TO CONSTRUCTION OF ROAD AND DRAINAGE FACILITIES.
- PRIOR TO SITE CONSTRUCTION, THE CONTRACTOR IS RESPONSIBLE FOR LOCATING UNDERGROUND UTILITIES. CALL THE UNDERGROUND UTILITY LOCATION SERVICE AT 456-8000, BEFORE YOU DIG.
- IF THE CONTRACTOR DISCOVERS ANY DISCREPANCIES BETWEEN THE PLANS AND EXISTING CONDITIONS ENCOUNTERED, THEY SHALL IMMEDIATELY NOTIFY THE DESIGN ENGINEER, CLC ASSOCIATES @ 458-6840, THE SITE/PROJECT INSPECTING ENGINEER OR HIS REPRESENTATIVE, STI NORTHWEST, BRUCE HOWARD @ 534-9711, AND THE SPOKANE COUNTY ENGINEER'S OFFICE @ 477-3600.
- FOR CONSTRUCTION OF DRYWELLS, INSTALL FILTER FABRIC "AMOCO" 4545 OR APPROVED EQUIVALENT, BETWEEN THE DRYWELL BARREL AND THE WASHED DRAINROCK, AND BETWEEN THE WASHED DRAINROCK AND NATIVE SOILS. SEE SPOKANE COUNTY STANDARD DETAIL B-1A.
- THE CONTRACTOR SHALL MAKE AN EFFORT TO PROTECT ALL CATCH BASINS AND DRYWELLS FROM BEING CONTAMINATED WITH SILT BY INSTALLING FILTER FABRIC BETWEEN THE RIM AND GRATE FOR AT LEAST 6 WEEKS, OR UNTIL THE ESTABLISHMENT OF GRASS AND/OR OTHER SITE CONSTRUCTION WORK HAS ENDED. IN THE EVENT THAT SILT OR OTHER DELETERIOUS MATERIAL IS ALLOWED TO ENTER A DRYWELL OR CATCH BASIN, THE CONTRACTOR WILL BE REQUIRED TO CLEAN THE DRYWELL OR CATCH BASIN TO THE SATISFACTION OF THE CERTIFYING ENGINEER.
- ALL DRYWELL CONNECTION PIPES SHALL BE PLACED BELOW THE DRYWELL CONCRETE CONE AND SHALL FLOW AS DIRECTED IN THE PLANS.
- ALL CURB DROP INLETS ARE TO HAVE A 2" DEPRESSION PER FIGURE 48, PAGE 6-84 OF THE SPOKANE COUNTY GUIDELINES FOR STORM WATER MANAGEMENT. ALL GUTTER INLETS SHALL BE CONSTRUCTED PER STANDARD DETAIL B-18.
- THE CONTRACTOR SHALL BE RESPONSIBLE FOR CLEANING DIRT, MUD, AND OTHER CONSTRUCTION DEBRIS WHICH MAY ACCUMULATE ON PAVED STREETS ADJACENT TO THE SITE AS A RESULT OF THE CONSTRUCTION ACTIVITY. CLEANING SHALL BE ON AN "AS NEEDED" BASIS USING WATER UNDER PRESSURE. SWEEPING AND WATER SHALL BE USED WHEN WATER PRESSURE ALONE WILL NOT WASH THE CONSTRUCTION DEBRIS FROM THE STREET.
- FOR ANY CURB GRADE LESS THAN 0.8% (0.0080 FT/FT), A WASHINGTON STATE PROFESSIONAL LAND SURVEYOR SHALL VERIFY THAT THE CURB FORMS ARE AT THE GRADES NOTED ON THE APPROVED PLANS, PRIOR TO PLACEMENT OF CURB CONCRETE. THE CONTRACTOR IS RESPONSIBLE FOR ARRANGING AND COORDINATING WORK WITH THE PROFESSIONAL LAND SURVEYOR.
- THE CONTRACTOR SHALL EMPLOY A LICENSED SURVEYOR TO VERIFY THAT THE CROSS-GUTTER FORMS ARE AT THE CORRECT PLANE GRADE PRIOR TO CONCRETE PLACEMENT. THE CROSS-GUTTER SHALL BE CONSTRUCTED PRIOR TO PAVING, AND THE PAVEMENT SHALL THEN MATCH THE EDGE OF THE CONCRETE GUTTER.
- THE FLOOR OF A GRASSED PERCOLATION AREA (GPA) SWALE INCLUDES THE LEVEL PORTION OF THE FLOOR OF THE SWALE AND THE SIDESTEPS OF THE SWALE UP TO THE GPA OVERFLOW ELEVATION OR TOP OF DRYWELL. THE SOIL LOCATED IN THE FLOOR OF THE GPA SWALE SHALL BE A MEDIUM TO WELL DRAINING MATERIAL, WITH A MINIMUM INFILTRATION RATE OF 0.5 INCHES PER HOUR. THE ENGINEER SHALL PROVIDE A WRITTEN STATEMENT WHICH VERIFIES THAT ALL GPA SWALES CONFORM TO THIS REQUIREMENT. THIS WRITTEN STATEMENT SHALL BE SUBMITTED TO THE SPOKANE COUNTY ENGINEER'S OFFICE PRIOR TO INSTALLING FINISHED LANDSCAPING AND PRIOR TO FINAL ACCEPTANCE. THE SWALE FLOOR MATERIAL SHALL BE INSTALLED TO A NATIVE SOIL STRATUM WHICH ALSO MEETS OR EXCEED THIS MINIMUM PERCOLATION RATE OF 0.5 INCHES PER HOUR.
- THE CONTRACTOR IS RESPONSIBLE FOR PROVIDING ALL LABOR AND MATERIALS NECESSARY FOR THE COMPLETION OF THE INTENDED IMPROVEMENTS SHOWN ON THESE DRAWINGS OR DESIGNATED TO BE PROVIDED, INSTALLED OR CONSTRUCTED, UNLESS SPECIFICALLY NOTED OTHERWISE.
- ALL STORM DRAIN PIPES TO BE INSTALLED PER MANUFACTURERS SPECIFICATIONS.
- ER1 AN EROSION/SEDIMENTATION CONTROL (ESC) PLAN IS REQUIRED FOR THIS PROJECT. IMPLEMENTATION OF THE ESC PLAN, AND CONSTRUCTION, MAINTENANCE, AND UPGRADING OF THE ESC FACILITIES ARE THE RESPONSIBILITY OF THE DEVELOPER UNTIL ALL CONSTRUCTION IS COMPLETED AND ACCEPTED BY SPOKANE COUNTY, OR UNTIL VEGETATION IS ESTABLISHED THROUGHOUT THE SITE, AND ACCEPTED BY THE COUNTY SPOKANE, WHICHEVER IS LATER.
- ER2 APPROVAL OF THE ESC PLAN DOES NOT CONSTITUTE APPROVAL OF ANY OF THE PROPOSED ROAD, STORM DRAINAGE, GRADING OR UTILITY DESIGN ELEMENTS SHOWN ON THE ESC PLAN.
- ER3 THE EROSION/SEDIMENTATION CONTROL MEASURES SHOWN ARE THE MINIMUM REQUIREMENTS FOR THE ANTICIPATED SITE CONDITIONS. THE CONTRACTOR SHALL INSPECT AND MAINTAIN THESE ESC MEASURES DAILY, AND SHALL MAINTAIN AND UPGRADE THESE MEASURES AS NECESSARY TO PREVENT SEDIMENT-LADEN WATER FROM EITHER FLOWING OFF THE SITE, OR INTO NEW/EXISTING STORM DRAINAGE FACILITIES, SUCH AS DRYWELLS, CULVERTS, OR GRAVEL GALLERIES.
- ER4 THE CONTRACTOR/DEVELOPER IS RESPONSIBLE FOR INSTALLING ROCK CONSTRUCTION ENTRIES AT ANY AND ALL LOCATIONS USED TO ENTER OR EXIT THE PROJECT SITE.
- ER5 GEOTEXTILE FABRIC IS TO BE PLACED ON THE RIMS OF DRYWELLS, CATCH BASINS AND INLETS UNTIL SUCH TIME THE VEGETATION ON THE SITE IS ESTABLISHED AND THE THREAT OF SEDIMENT DEPOSITION INTO THE DRAINAGE SYSTEM IS MITIGATED.

Associates, Inc.  
Planning  
Engineering  
Architecture  
Landscape Architecture  
Land Surveying  
707 W. 7th Avenue, Suite 200  
Spokane, WA 99204  
Phone: (509) 458-6840  
Fax: (509) 458-6844

JOHN FRANK SAYMERS  
STATE OF WASHINGTON  
REGISTERED PROFESSIONAL ENGINEER  
36212  
EXPIRES 5/18/04

PREPARED UNDER THE DIRECT SUPERVISION OF JOHN F. SAYMERS, P.E. WASHINGTON REGISTRATION NO. 36212 FOR AND ON BEHALF OF CLC ASSOCIATES, INC.

Date	Description
02/28/01	PRELIMINARY SUBMITTAL
07/30/03	SECOND SUBMITTAL
03/12/03	THIRD SUBMITTAL
05/25/03	FINAL SUBMITTAL
8/26/04	RECORD DRAWING

By STI Northwest, Inc.

Project Number: S000588  
CLC Job Number: S000588  
Drawn By: EMT,SMM  
Designed By: EMT  
Checked By: JFS  
THESE PLANS ARE INSTRUMENTS OF PROFESSIONAL SERVICE AND ARE PROTECTED BY COMMON LAW, STATUTE AND OTHER RESPECTIVE RIGHTS INCLUDING COPYRIGHT. THEY MAY NOT BE REPRODUCED OR USED FOR ANY PURPOSE WITHOUT THE WRITTEN CONSENT OF CLC ASSOCIATES, INC. (AN AFFILIATE OF COLUMBIA LAND CONSULTANTS, INC.)

STREET CONSTRUCTION PLANS  
BLUE FOX — WOODLAND ESTATES PUD  
COVER SHEET  
SPOKANE COUNTY, WASHINGTON

Street Title  
STREET PLAN  
COVER SHEET  
Street Number  
1 OF 10


P.1729H Eng. A. Bull

# RECORD DRAWING

### LEGEND

- EXISTING SANITARY SEWER MANHOLE
- ⊕ PROPOSED WSDOT TYPE 2 CATCH BASIN
- EXISTING WSDOT GRATE INLET TYPE 2
- ▬ PROPOSED WSDOT GRATE INLET TYPE 2
- ▬ PROPOSED STORM DRAIN
- ▬ EXISTING CURB
- ▬ PROPOSED ROLLED CURB
- ▬ SURFACE FLOW DIRECTION


UNDERGROUND SERVICE ALERT  
ONE-CALL NUMBER  
**456-8000**  
CALL TWO BUSINESS DAYS  
BEFORE YOU DIG

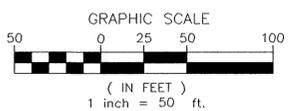

### CONSTRUCTION NOTES:

- ① WSDOT GRATE INLET TYPE 2 PER WSDOT STD. PLANS B-4c; SEE PROFILE THIS SHEET.
- ② WSDOT CATCH BASIN TYPE 2 WITH MANHOLE RING AND SOLID COVER PER WSDOT STD. PLAN B-1e, D=48"; SEE PROFILE THIS SHEET.
- ③ WSDOT CATCH BASIN TYPE 2 WITH MANHOLE RING AND SOLID COVER PER WSDOT STD. PLAN B-1e, D=48"; SEE PROFILE THIS SHEET.
- ④ 61 L.F. 15" CMP; SEE PROFILE THIS SHEET.
- ⑤ 124 L.F. 15" CMP; SEE PROFILE THIS SHEET.
- ⑥ ADJUST EXISTING SEWER MANHOLE TO GRADE.
- ⑦ EXISTING WSDOT CATCH BASIN TYPE 2, PER WSDOT STANDARD PLANS B-4B, C AND TYPE 5 FRAME AND GRATE PER SPOKANE COUNTY STANDARD PLAN B-15.
- ⑧ EXISTING PIPING SYSTEM TO TRACT "A", SEE SHEET 5 OF 8.
- ⑨ 50 L.F. 15" CMP; SEE PROFILE THIS SHEET
- ⑩ EXISTING DITCH LOCATED ON SOUTH BOUNDARY


CURVE TABLE					
CURVE	RADIUS	LENGTH	TANGENT	CHORD	DELTA
C1	30.00	49.23	32.18	43.89	94°00'57"
C2	30.00	39.14	22.92	36.42	74°45'27"
C3	150.00	72.91	37.19	72.19	27°50'57"
C4	150.00	42.24	21.26	42.10	16°08'10"
C5	985.00	126.09	63.13	126.00	7°20'04"
C6	340.00	87.05	43.76	86.81	14°40'08"
C7	985.00	126.09	63.13	126.00	7°20'04"
C10	150.00	98.82	51.28	97.04	37°44'51"

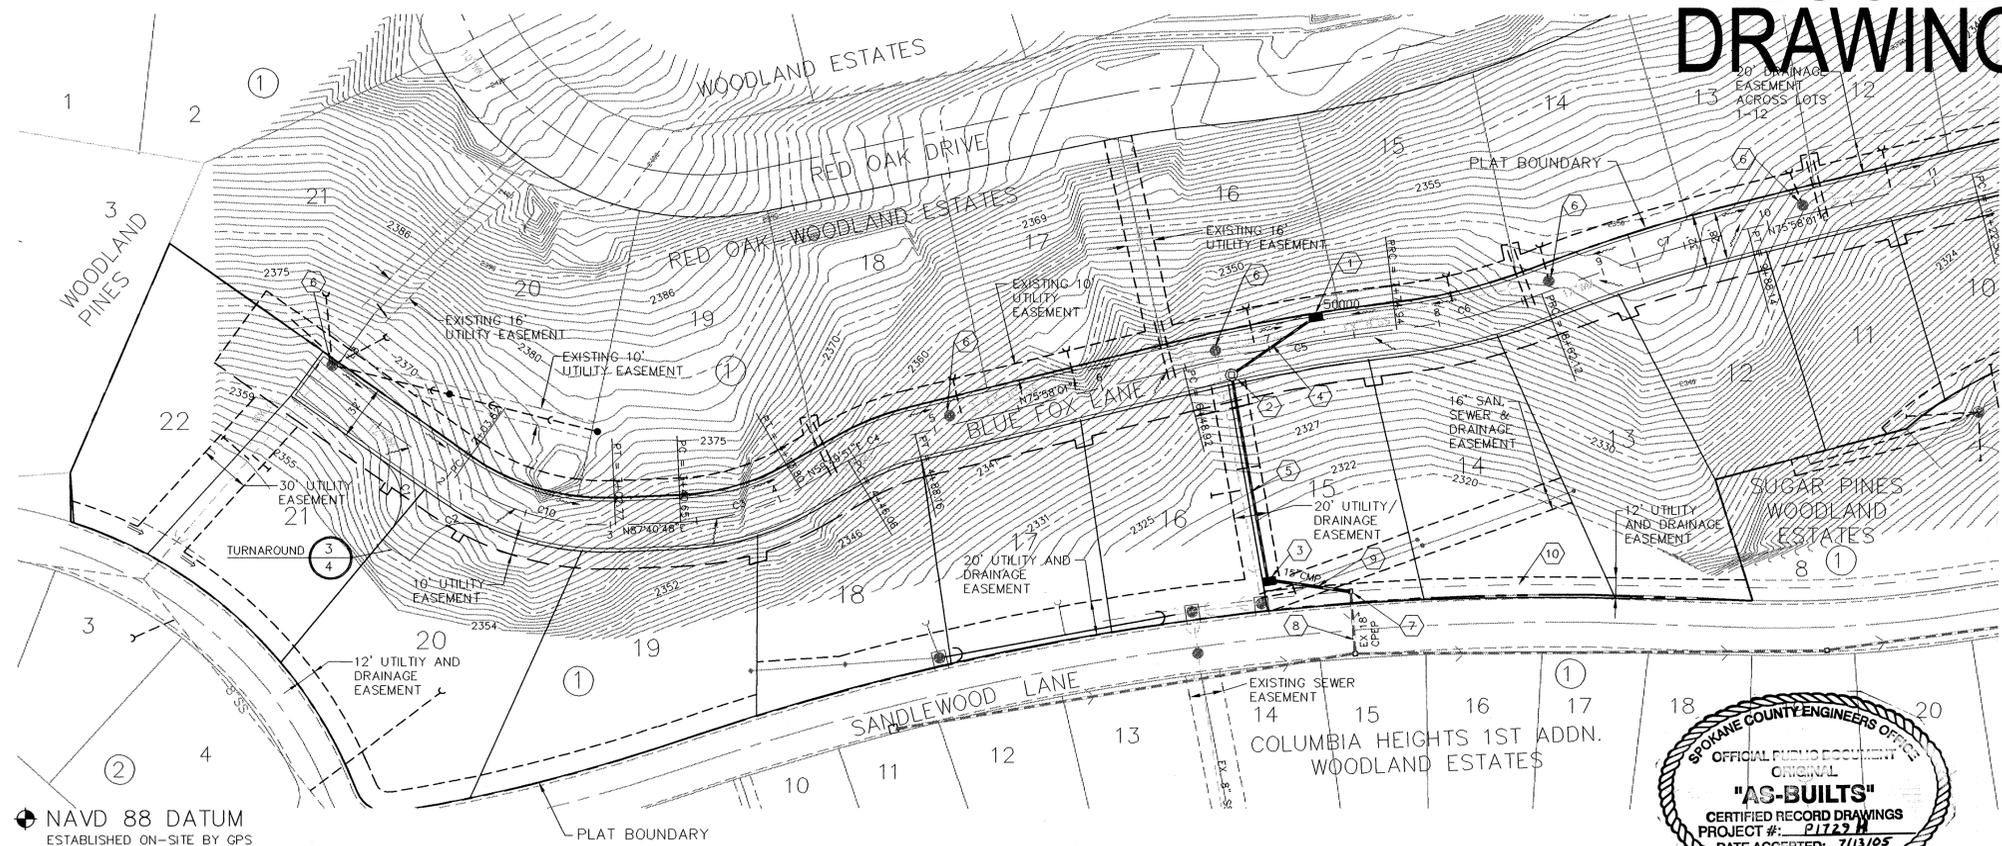

NAVD 88 DATUM  
ESTABLISHED ON-SITE BY GPS  
SURVEY PERFORMED 11/21/00  
BASED ON WSDOT MONUMENTS  
GP32290-143 AND GP33290-147

SPOKANE COUNTY ENGINEERS OFFICE  
OFFICIAL PUBLIC DOCUMENT  
ORIGINAL  
"AS-BUILTS"  
CERTIFIED RECORD DRAWINGS  
PROJECT #: P1727  
DATE ACCEPTED: 7/13/05

DEVELOPER'S APPROVAL \_\_\_\_\_ DATE \_\_\_\_\_

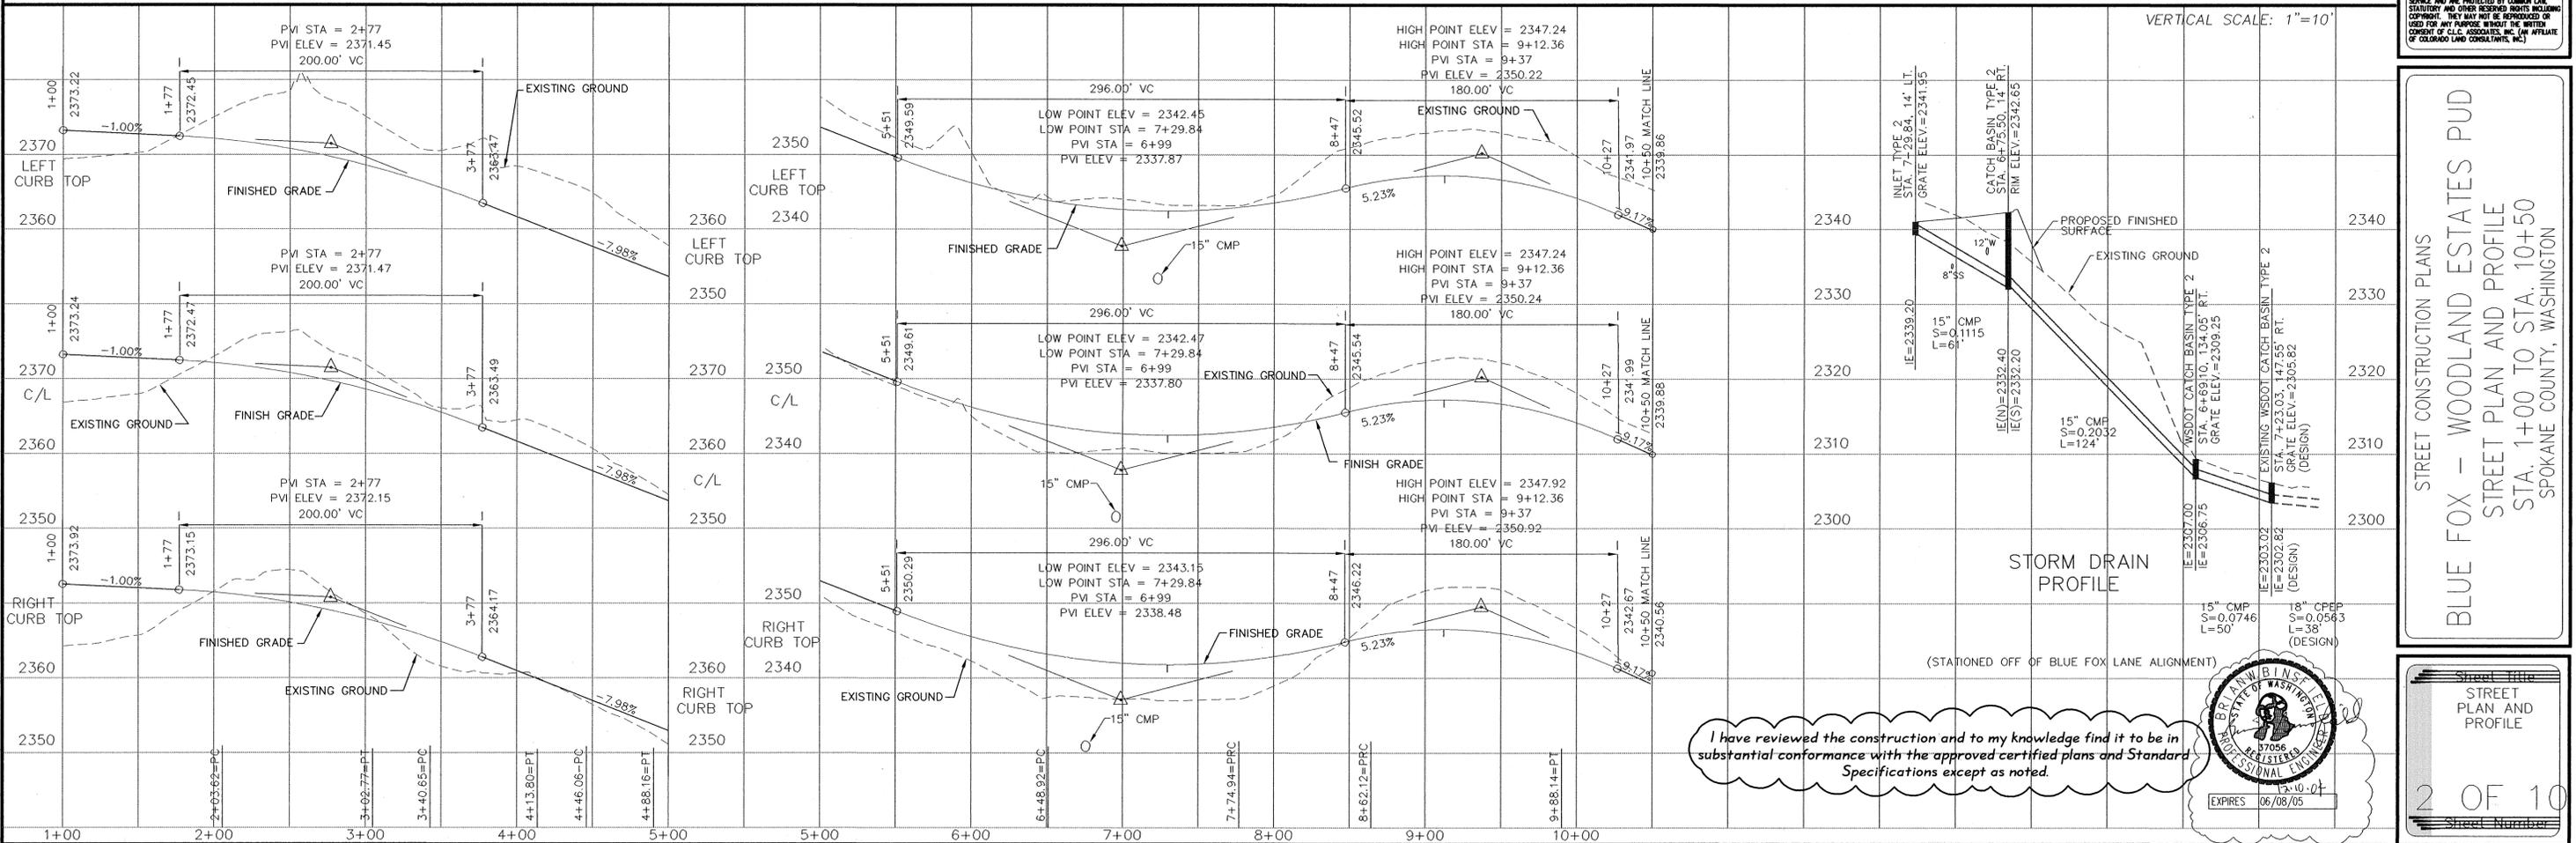

I have reviewed the construction and to my knowledge find it to be in substantial conformance with the approved certified plans and Standard Specifications except as noted.

BRITAIN W. B. NIELSEN  
STATE OF WASHINGTON  
PROFESSIONAL ENGINEER  
No. 27056  
EXPIRES 06/08/05

STREET CONSTRUCTION PLANS  
BLUE FOX - WOODLAND ESTATES PUD  
STREET PLAN AND PROFILE  
STA. 1+00 TO STA. 10+50  
SPOKANE COUNTY, WASHINGTON

Sheet Title  
STREET PLAN AND PROFILE  
2 OF 10  
Sheet Number

Associates, Inc.  
Planning  
Engineering  
Architecture  
Landscape Architecture  
Land Surveying  
707 W. 7th Avenue, Suite 200  
Spokane, WA 99204  
Phone: (509) 456-8840  
Fax: (509) 456-8844

JOHN FRANK SAYWERS  
STATE OF WASHINGTON  
PROFESSIONAL ENGINEER  
36212 REGISTERED  
EXPIRES 5/18/04

PREPARED UNDER THE DIRECT SUPERVISION OF  
JOHN F. SAYWERS, P.E.  
WASHINGTON REGISTRATION NO. 36212  
FOR AND ON BEHALF OF  
CLC ASSOCIATES, INC.

Date Description  
02/08/01 ORIGINAL PREPARATION  
06/10/02 FIRST SUBMITTAL  
07/20/02 SECOND SUBMITTAL  
03/12/03 THIRD SUBMITTAL  
05/28/03 FINAL SUBMITTAL  
8-26-04 RECORD DRAWING  
by STI Northwest, Inc.


Project Number: S000588  
CLC Job Number: S000588  
Drawn By: EMT, SMM  
Designed By: EMT  
Checked By: TRW  
THESE PLANS ARE INSTRUMENTS OF PROFESSIONAL SERVICE AND ARE PROTECTED BY COMMON LAW, STATUTE AND OTHER RESERVE RIGHTS INCLUDING COPYRIGHT. THEY MAY NOT BE REPRODUCED OR USED FOR ANY PURPOSE WITHOUT THE WRITTEN CONSENT OF CLC ASSOCIATES, INC. (AN AFFILIATE OF COLORADO LAND CONSULTANTS, INC.)

# RECORD DRAWING

### LEGEND


- EXISTING SANITARY SEWER MANHOLE
- ⊕ PROPOSED WSDOT TYPE 1-L CATCH BASIN
- ⊖ EXISTING WSDOT GRATE INLET TYPE 2
- ⊖ PROPOSED WSDOT GRATE INLET TYPE 2
- PROPOSED STORM DRAIN
- EXISTING CURB
- PROPOSED ROLLED CURB
- SURFACE FLOW DIRECTION

UNDERGROUND SERVICE ALERT  
ONE-CALL NUMBER  
**456-8000**  
CALL TWO BUSINESS DAYS  
BEFORE YOU DIG

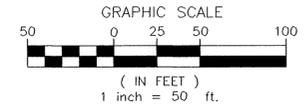

### CONSTRUCTION NOTES:

- ① W.S.D.O.T. GRATE INLET TYPE 2 PER W.S.D.O.T. STD. PLANS B-4b,c; STA. 17+70, 14' LT. GRATE ELEV.=2297.54
- ② 10 L.F. 12" CMP @ S=0.0400 FT./FT. I.E.(W)=2295.00; I.E.(E)=2294.60
- ③ W.S.D.O.T. GRATE INLET TYPE 2 PER W.S.D.O.T. STD. PLANS B-4b,c; STA. 17+80, 14' LT. GRATE ELEV.=2296.90;
- ④ 93 L.F. 12" CMP @ S=0.0131 FT./FT. I.E.(W)=2294.50; I.E.(E)=2293.38
- ⑤ CURB TRANSITION FROM TYPE 'R' ROLLED CURB TO EXISTING TYPE 'B' CURB AND GUTTER. SEE DETAIL 6, SHEET 4 OF 8.
- ⑥ ADJUST EXISTING MANHOLE RIM TO GRADE.
- ⑦ NOT USED
- ⑧ EXISTING WSDOT GRATE INLET CONTRACTOR TO VERIFY EXISTING INVERT ELEV. PRIOR TO CONSTRUCTION.
- ⑨ STREET AND STOP SIGN PER M.U.T.C.D. AND SPOKANE COUNTY STANDARD PLAN A-16.
- ⑩ EXISTING CONCRETE CROSS GUTTER TYPE 1, PER SPOKANE COUNTY STANDARD PLAN B-18. SEE SHEET 2 OF 6 OF RED OAK APPROVED PLANS (ATTACHED) FOR DETAILS.
- ⑪ EXISTING DRAINAGE DITCH LOCATED ON NORTH SIDE OF SANDALWOOD LANE.


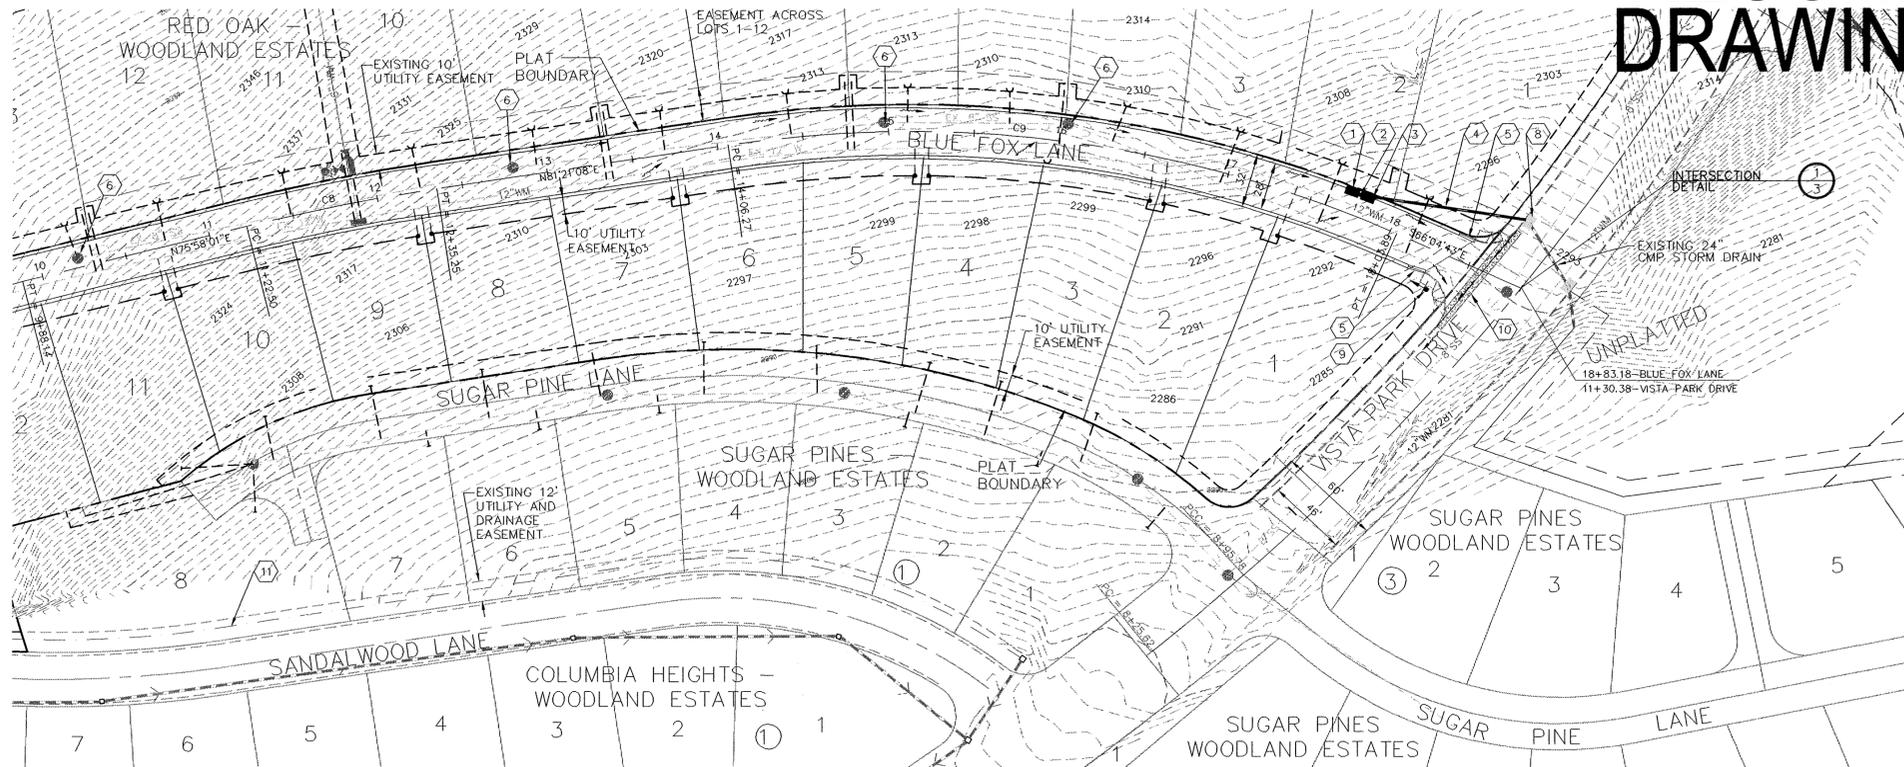


NAVD 88 DATUM  
ESTABLISHED ON-SITE BY GPS  
SURVEY PERFORMED 11/21/00  
BASED ON WSDOT MONUMENTS  
GP32290-143 AND GP33290-147



CURVE	RADIUS	LENGTH	TANGENT	CHORD	DELTA
C8	1200.00	112.79	56.44	112.75	5°23'07"
C9	700.00	397.91	204.49	392.57	32°34'09"

DEVELOPER'S APPROVAL \_\_\_\_\_ DATE \_\_\_\_\_

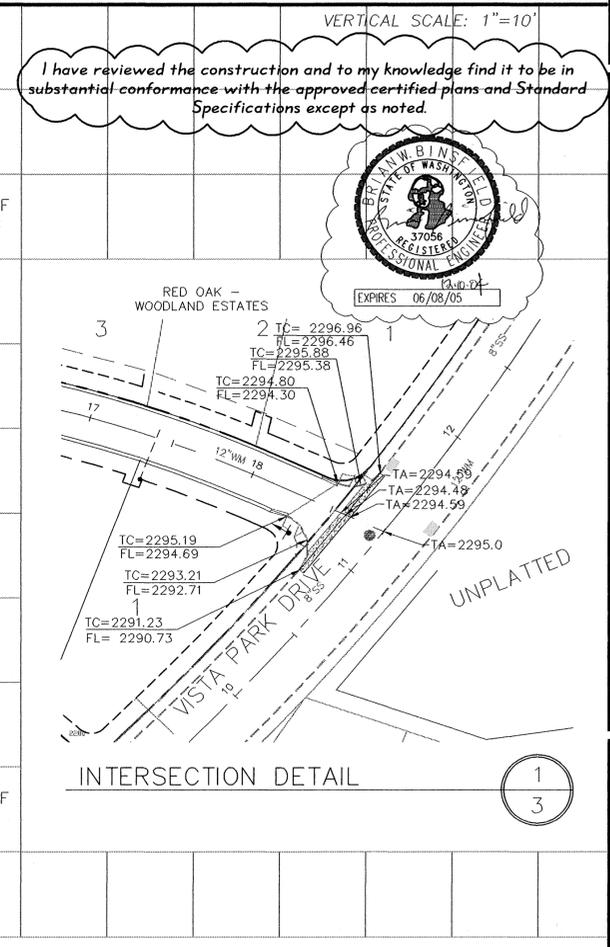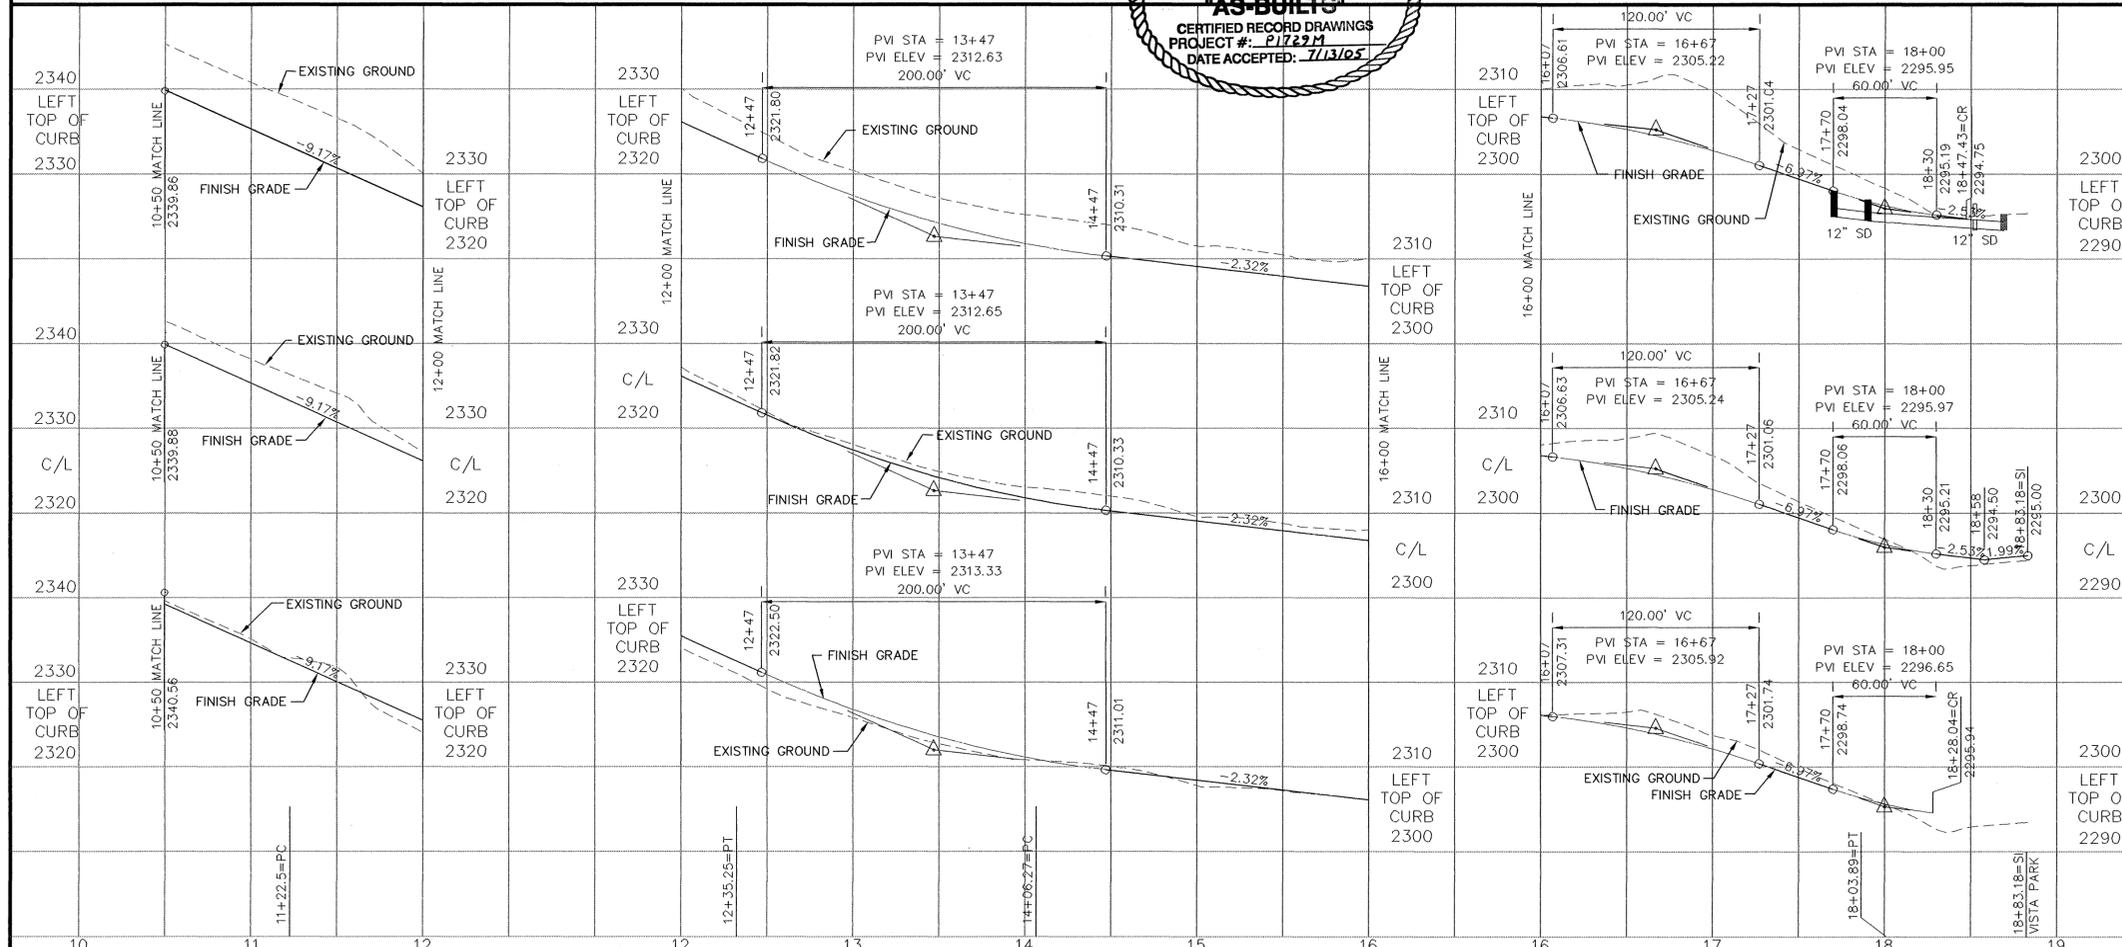

I have reviewed the construction and to my knowledge find it to be in substantial conformance with the approved certified plans and Standard Specifications except as noted.



STREET CONSTRUCTION PLANS  
BLUE FOX - WOODLAND ESTATES PUD  
STREET PLAN AND PROFILE  
STA. 10+50 TO STA. 18+83.18  
SPOKANE COUNTY, WASHINGTON

UNDERGROUND SERVICE ALERT  
 ONE-CALL NUMBER  
**456-8000**  
 CALL TWO BUSINESS DAYS  
 BEFORE YOU DIG

Associates, Inc.  
 Planning  
 Engineering  
 Architecture  
 Landscape Architecture  
 Land Surveying  
 707 W. 7th Avenue, Suite 200  
 Spokane, WA 99204  
 Phone: (509) 456-8040  
 Fax: (509) 456-8044



PREPARED UNDER THE DIRECT  
 SUPERVISION OF  
 JOHN F. SAYERS, P.E.  
 WASHINGTON REGISTRATION  
 NO. 36212  
 FOR AND ON BEHALF OF  
 CLC ASSOCIATES, INC.

Date	Description
02/27/01	PRELIMINARY SUBMITTAL
05/10/02	FIRST SUBMITTAL
07/30/02	SECOND SUBMITTAL
03/12/03	THIRD SUBMITTAL
05/28/03	FINAL SUBMITTAL
8/26/04	RECORD DRAWING


by STI Northwest, Inc.

Project Number: S000588  
 CLC Job Number: S000588  
 Drawn By: EMT, SMM  
 Designed By: EMT  
 Checked By: JFS


THESE PLANS ARE INSTRUMENTS OF PROFESSIONAL SERVICE AND ARE PROTECTED BY COMMON LAW, STATUTE AND OTHER RIGHTS INCLUDING COPYRIGHT. THEY MAY NOT BE REPRODUCED OR USED FOR ANY PURPOSE WITHOUT THE WRITTEN CONSENT OF CLC ASSOCIATES, INC. (AN AFFILIATE OF COLORADO LAND CONSULTANTS, INC.)

STREET CONSTRUCTION PLANS  
**BLUE FOX - WOODLAND ESTATES PUD**  
 STREET AND DRAINAGE DETAILS  
 SPOKANE COUNTY, WASHINGTON

Sheet Title  
 STREET AND DRAINAGE DETAILS  
 4 OF 10  
 Sheet Number

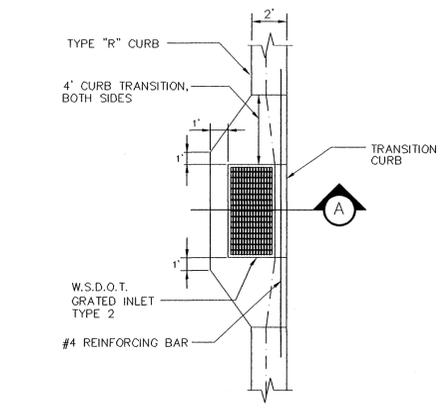


PLAN

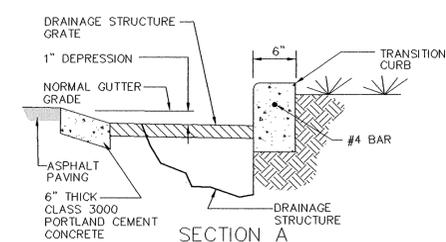


SECTION A

INLET APRON DETAIL  
 NOT TO SCALE

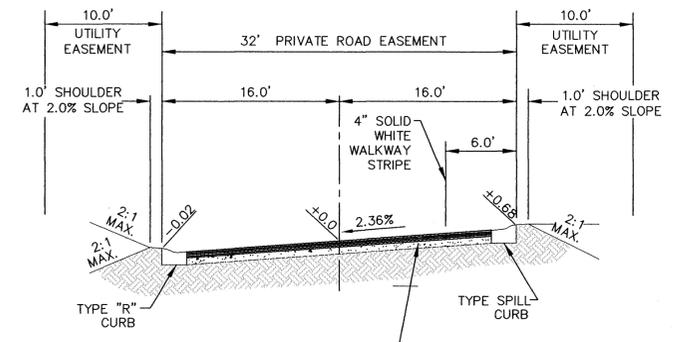

BLUE FOX LANE SECTION (PRIVATE ROAD)  
 NOT TO SCALE

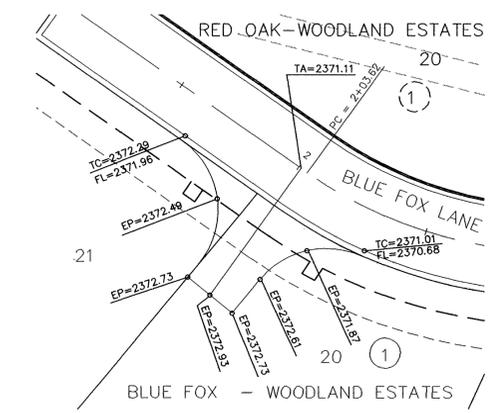

LEGEND

- EXISTING SANITARY SEWER MANHOLE
- ⊙ PROPOSED WSDOT TYPE 1-L CATCH BASIN
- EXISTING WSDOT GRATE INLET TYPE 2
- PROPOSED WSDOT GRATE INLET TYPE 2
- PROPOSED STORM DRAIN
- - - - EXISTING CURB
- PROPOSED ROLLED CURB
- ⇒ SURFACE FLOW DIRECTION



UNDERGROUND SERVICE ALERT  
ONE-CALL NUMBER  
**456-8000**  
CALL TWO BUSINESS DAYS  
BEFORE YOU DIG

Associates, Inc.  
Planning  
Engineering  
Architecture  
Landscape Architecture  
Land Surveying  
707 W. 7th Avenue, Suite 200  
Spokane, WA 99204  
Phone: (509) 456-8940  
Fax: (509) 456-8944

# RECORD DRAWING

JOHN FRANK SAYWERS  
STATE OF WASHINGTON  
REGISTERED  
PROFESSIONAL ENGINEER  
36212  
EXPIRES 5/18/04

PREPARED UNDER THE DIRECT  
SUPERVISION OF  
JOHN F. SAYWERS, P.E.  
WASHINGTON REGISTRATION  
NO. 36212  
FOR AND ON BEHALF OF  
CLC ASSOCIATES, INC.

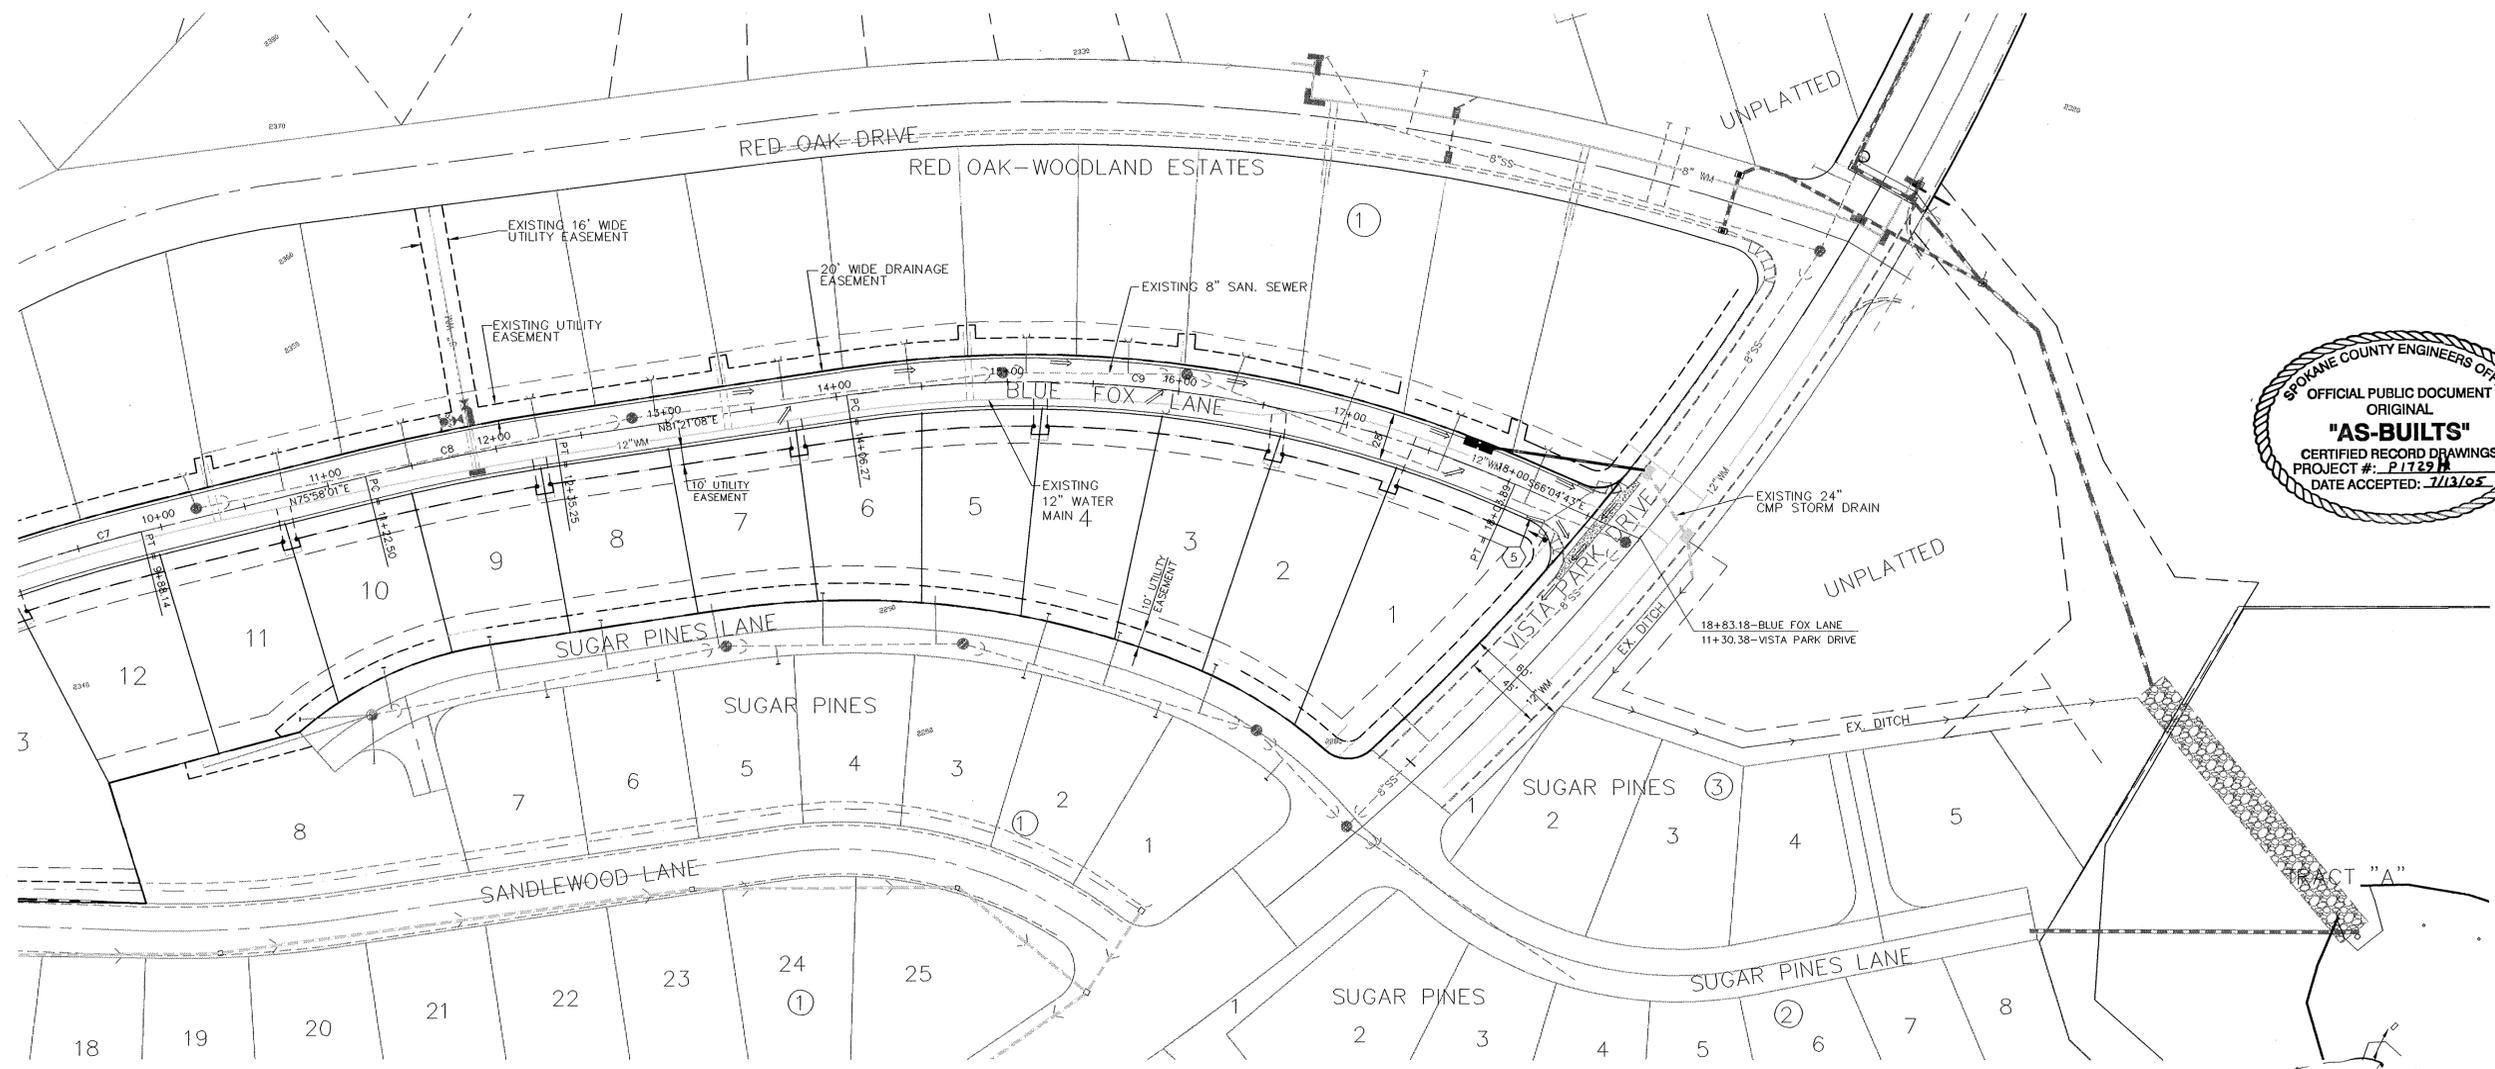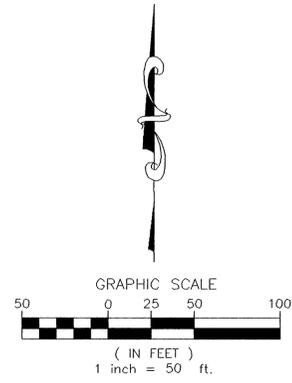

SPOKANE COUNTY ENGINEERS OFFICE  
OFFICIAL PUBLIC DOCUMENT  
ORIGINAL  
"AS-BUILTS"  
CERTIFIED RECORD DRAWINGS  
PROJECT #: P-1729 H  
DATE ACCEPTED: 7/13/05

Date	Description
02/27/01	ORIGINAL PREPARATION
05/10/02	FIRST SUBMITTAL
07/20/02	SECOND SUBMITTAL
03/12/03	THIRD SUBMITTAL
05/28/03	FINAL SUBMITTAL
8-26-04	RECORD DRAWING by STI Northwest, Inc.

Project Number: S000588  
CLC Job Number: S000588  
Drawn By: EMT, SMM  
Designed By: EMT  
Checked By: TRW  
THESE PLANS ARE INSTRUMENTS OF PROFESSIONAL SERVICE AND ARE PROTECTED BY COMMON LAW, STATUTE AND OTHER PROVISIONS INCLUDING COPYRIGHT. THEY MAY NOT BE REPRODUCED OR USED FOR ANY PURPOSE WITHOUT THE WRITTEN CONSENT OF CLC ASSOCIATES, INC. (AN AFFILIATE OF COLORADO LAND CONSULTANTS, INC.)

STREET CONSTRUCTION PLANS  
BLUE FOX - WOODLAND ESTATES PUD  
DRAINAGE DETAILS  
SPOKANE COUNTY, WASHINGTON

I have reviewed the construction and to my knowledge find it to be in substantial conformance with the approved certified plans and Standard Specifications except as noted.

BRIAN W. BINSFELD  
STATE OF WASHINGTON  
REGISTERED  
PROFESSIONAL ENGINEER  
37056  
EXPIRES 06/08/05

NAVD 88 DATUM  
ESTABLISHED ON-SITE BY GPS  
SURVEY PERFORMED 11/21/00  
BASED ON WSDOT MONUMENTS  
GP32290-143 AND GP33290-147

DEVELOPER'S APPROVAL \_\_\_\_\_ DATE \_\_\_\_\_

Sheet Title  
DETAIL SHEET  
5 OF 10  
Sheet Number

P-1729 H Eng As Built

UNDERGROUND SERVICE ALERT  
ONE-CALL NUMBER  
456-8000  
CALL TWO BUSINESS DAYS  
BEFORE YOU DIG

Associates, Inc.  
Planning  
Engineering  
Architecture  
Landscape Architecture  
Land Surveying  
707 W. 7th Avenue, Suite 200  
Spokane, WA 99204  
Phone: (509) 458-6840  
Fax: (509) 458-6844

JOHN FRANK SAYMERS  
REGISTERED PROFESSIONAL ENGINEER  
36212  
EXPIRES 5/18/04

PREPARED UNDER THE DIRECT  
SUPERVISION OF  
JOHN F. SAYMERS, P.E.  
WASHINGTON REGISTRATION  
NO. 36212  
FOR AND ON BEHALF OF  
CLC ASSOCIATES, INC.

CLC Job Number: S000588  
Drawn By: SKM, SMM  
Designed By: SKM  
Checked By: JFS  
DATE Description  
2/1/02 ORIGINAL PROPOSAL  
05/10/02 FIRST SUBMITTAL  
07/30/02 SECOND SUBMITTAL  
10/23/02 THIRD SUBMITTAL  
02/03/03 FORTH SUBMITTAL  
03/12/03 FIFTH SUBMITTAL  
05/08/03 FINAL SUBMITTAL  
8-26-04 RECORD DRAWING  
by STI Northwest, Inc.

THESE PLANS ARE INSTRUMENTS OF PROFESSIONAL SERVICE AND ARE PROTECTED BY COMMON LAW, STATUTE AND OTHER RESERVATION RIGHTS INCLUDING COPYRIGHT. THEY MAY NOT BE REPRODUCED OR USED FOR ANY PURPOSE WITHOUT THE WRITTEN CONSENT OF CLC ASSOCIATES, INC. (AN AFFILIATE OF COLORADO LAND CONSULTANTS, INC.)

STREET AND DRAINAGE CONSTRUCTION PLANS  
BLUE FOX - WOODLAND ESTATES PUD  
DRAINAGE DETAILS  
SPOKANE COUNTY, WA

DETAIL SHEET  
6 OF 10  
Sheet Title  
Street Number

CONSTRUCTION NOTES

- EXISTING 4' KEYSTONE TYPE RETAINING WALL TO BE REMOVED.
- EXISTING FLOW RESTRICTOR MANHOLE PER DETAIL 3 THIS SHEET.
- EXISTING DRYWELLS TO BE REMOVED.
- EXISTING FENCE.
- EXISTING W.S.D.O.T. GRATE INLETS TYPE 2.
- EXISTING DISCHARGE STRUCTURE FROM SUGAR PINES ADDITION. RIM ELEV.=2192.20. CONTRACTOR SHALL REMOVE CONE AND ADD ONE MANHOLE SECTION. REINSTALL CONE AND ADJUST RING AND TRASH RACK TO 8" ABOVE POND BOTTOM.
- TYPE "B" DRYWELL W/TYPE 4 METAL FRAME AND GRATE PER SPOKANE COUNTY STANDARD PLAN B-1A. (RIM EL= 2196.67). N=7704.97, E=12463.00
- TYPE "B" DRYWELL W/TYPE 4 METAL FRAME AND GRATE PER SPOKANE COUNTY STANDARD PLAN B-1A. (RIM EL= 2196.67). N=7697.49, E=12496.42
- 3.0' RETAINING WALL; TOP OF WALL ELEV.=2199.00. SEE DETAIL 4 SHEET 7.
- CONTRACTOR SHALL FIELD VERIFY IF TOE DRAIN HAS BEEN INSTALLED. IF TOE DRAIN HAS BEEN INTALLED, VERIFY INSTALLATION IS PER SPECIFICATIONS OF THE JUNE 2, 1994 GEOTECHNICAL EVALUATION OF THE NORTHWOOD POND BY HOWARD CONSULTANTS. IF THE TOE DRAIN IS NOT PRESENT IT NEEDS TO BE INSTALLED PER SPECIFICATIONS. SEE DETAIL 5 SHEET 7.
- EXISTING 24" CMP OUTLET IE=2189.75. CONTRACTOR SHALL INSTALL WSDOT TYPE 2 INLET PER WSDOT STANDARD DETAIL B-4C RIM EL=2196.67 AND CONNECT TO EXISTING OUTLET.
- EXISTING 24" CMP INLET.




GENERAL NOTES

- AT LEAST 5 FEET OF UNDISTURBED GROUND MUST BE PROVIDED BETWEEN THE EXISTING FENCE AND NEW POND GRADING.
- THE SOUTHEAST OR DOWN-GRADIENT SIDE OF THE POND CANNOT BE RE-GRADED OR DISTURBED.
- THE POND BOTTOM MUST BE SEEDED PER SEED MIX SHEET 6A AFTER CONSTRUCTION ACTIVITIES.
- CONTRACTOR SHALL REMOVE EXISTING SOIL UNTIL SAND IS EXPOSED. ONCE SAND IS EXPOSED THEN FILL POND BOTTOM TO CORRECT ELEVATION (2196').
- CONTRACTOR IS TO PLACE ALL FILL LOOSELY AND FLOOD POND AFTER PLACING THE FILL. THE POND SHOULD THEN BE RE-LEVELED AND SEEDED.

RECORD DRAWING


NOTE:  
A 1 FOOT SECTION OF THE 12" RISER SHOULD BE CONSTRUCTED WITH A CAP WELDED ONTO THE TOP END. THE INLET AND OUTLET PIPES SHALL BE CONSTRUCTED PER DETAILS INCLUDING THE SLIDE GATE ASSEMBLY. SLIDE GATE TO BE LEFT IN CLOSED POSITION.

72" DIAMETER CONCRETE MANHOLE WITH FLAT COVER SECTION 72" DIAMETER TO BE MAINTAINED FROM BOTTOM TO TOP SLAB. ALL OTHER ITEMS OF CONSTRUCTION TO BE PER MANHOLE TYPE II-71 SPOKANE COUNTY UTILITY STANDARDS (SHEET U-4). MANHOLE STEPS TO BE PER SPOKANE COUNTY DETAIL U-8.

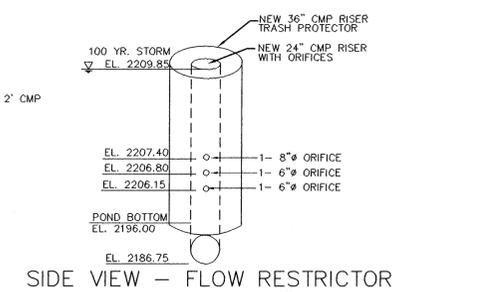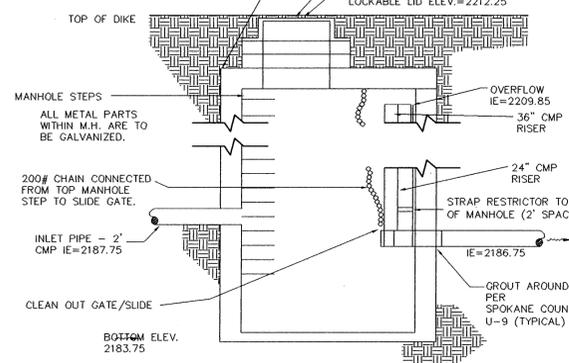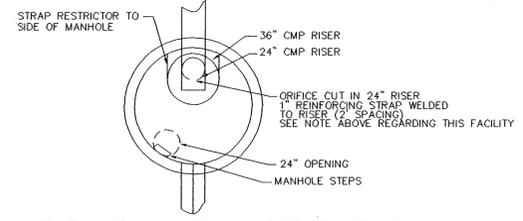


EXISTING FLOW RESTRICTOR MANHOLE

NOT TO SCALE

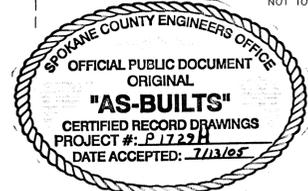


I have reviewed the construction and to my knowledge find it to be in substantial conformance with the approved certified plans and Standard Specifications except as noted.

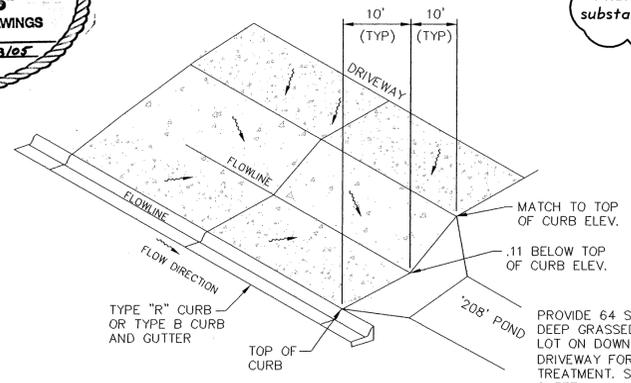

DRIVEWAY DETAIL

NO SCALE

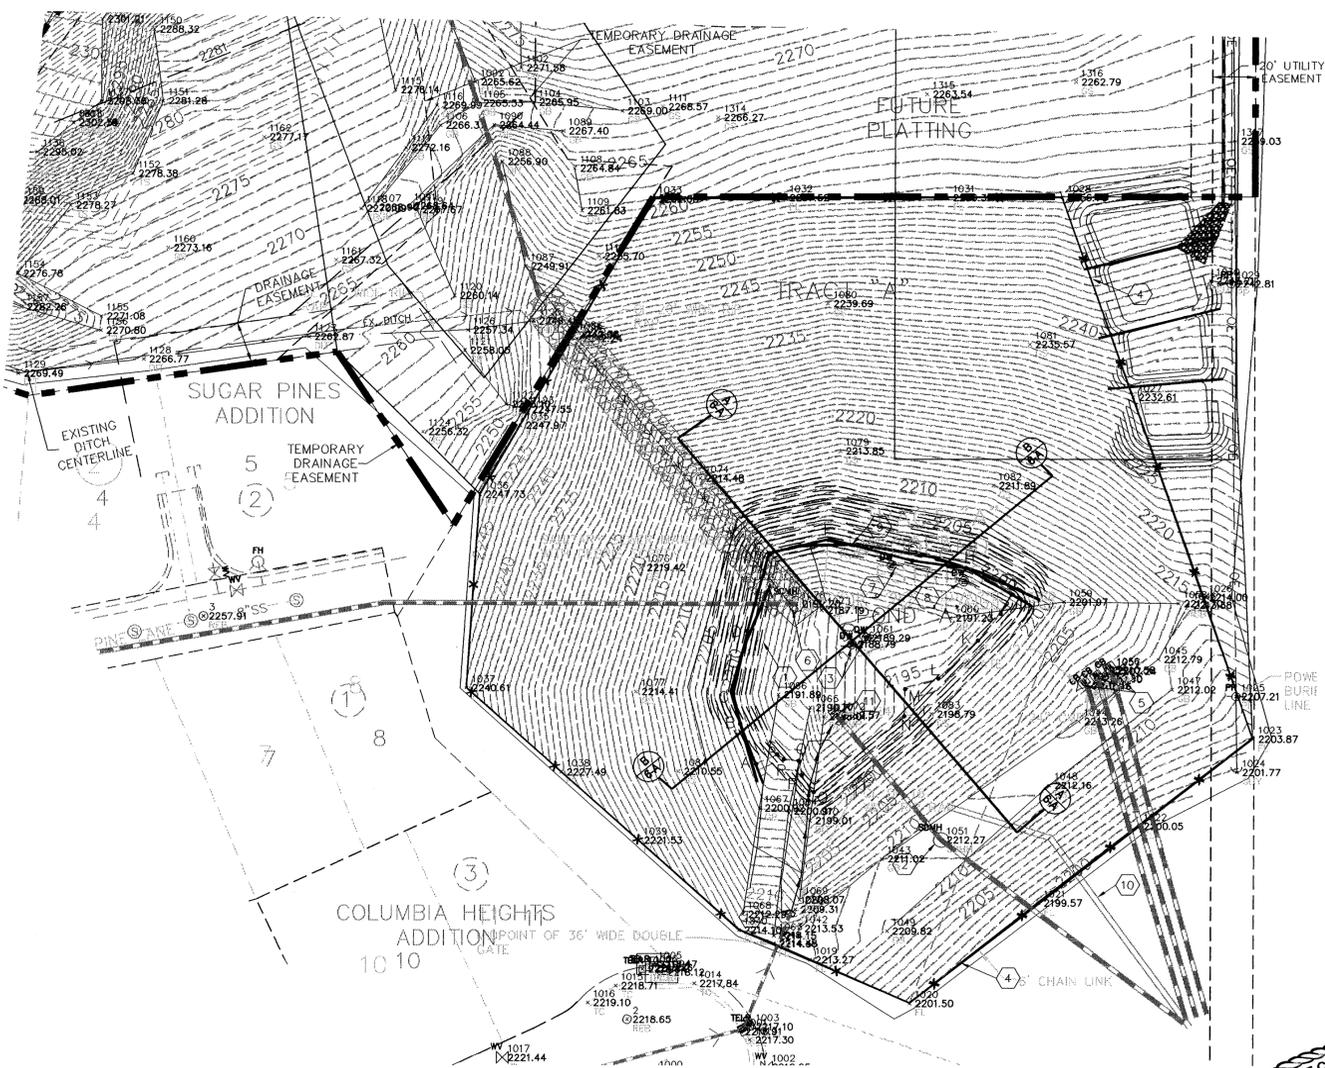


POND 'A'

SCALE: 1"=40'  
POND BOTTOM ELEV = 2196  
POND BOTTOM AREA = 9,186 SQ FT  
PERIMETER = 398.13 L.F.  
REQUIRED '208' VOLUME = 6,305 CF  
PROVIDED '208' VOLUME = 6,339 CF (8" DEPTH)

POND BOTTOM LOCATION TABLE (VISTA PARK DRIVE, STATION & OFFSET)			POND BOTTOM LOCATION TABLE (VISTA PARK DRIVE, STATION & OFFSET)		
POINT	STATION	OFFSET	POINT	STATION	OFFSET
A	11+39	503.55' RT.	K	12+18.50	550.77' RT.
B	11+46.54	486.01' RT.	L	12+00.06	546.45' RT.
C	11+53.13	474.74' RT.	M	11+90.47	548.35' RT.
D	11+74.14	461.65' RT.	N	11+82.86	544.26' RT.
E	12+00.97	447.86' RT.	O	11+43.63	532.77' RT.
F	12+17.51	466.79' RT.	P	11+45.74	523.47' RT.
G	12+27.99	504.17' RT.	Q	11+48.92	518.28' RT.
H	12+36.42	526.78' RT.	R	11+46.17	512.32' RT.
I	12+37.92	551.05' RT.	S	11+46.06	508.43' RT.
J	12+30.30	552.16' RT.			

POND BOTTOM DIMENSION TABLE			POND BOTTOM DIMENSION TABLE		
POINTS	LENGTH		POINTS	LENGTH	
A-B	20.25'		M-N	12.76'	
B-C	14.54'		N-O	55.84'	
C-D	30.38'		O-P	10.25'	
D-E	37.87'		P-Q	6.76'	
E-F	28.97'		Q-R	7.04'	
F-G	39.91'		R-S	3.89'	
G-H	25.34'		S-A	10.71'	
H-I	24.36'				
I-J	10.59'				
J-K	16.37'				
K-L	25.88'				
L-M	16.42'				

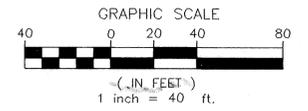

NAVD 88 DATUM  
ESTABLISHED ON-SITE BY GPS  
SURVEY PERFORMED 11/21/00  
BASED ON WSDOT MONUMENTS  
GP 32290-143 AND GP 33290-147

DEVELOPER'S APPROVAL

DATE

P-1729M Eng As-Built

CONSTRUCTION NOTES

1. EXISTING 4' KEYSTONE TYPE RETAINING WALL TO BE REMOVED.
2. EXISTING FLOW RESTRICTOR MANHOLE PER DETAIL 3 THIS SHEET.
3. EXISTING DRYWELLS TO BE REMOVED.
4. EXISTING FENCE.
5. EXISTING W.S.D.O.T. GRATE INLETS TYPE 2.
6. EXISTING DISCHARGE STRUCTURE FROM SUGAR PINES ADDITION. RIM ELEV.=2192.20. CONTRACTOR SHALL REMOVE CONE AND ADD ONE MANHOLE SECTION. REINSTALL CONE AND ADJUST RING AND TRASH RACK TO 8" ABOVE POND BOTTOM.
7. TYPE "B" DRYWELL W/TYPE 4 METAL FRAME AND GRATE PER SPOKANE COUNTY STANDARD PLAN B-1A. (RIM EL= 2196.67). N=7704.97, E=12463.00
8. TYPE "B" DRYWELL W/TYPE 4 METAL FRAME AND GRATE PER SPOKANE COUNTY STANDARD PLAN B-1A. (RIM EL= 2196.67). N=7697.49, E=12496.42
9. 11.0' RETAINING WALL: TOP OF WALL ELEV.=2207.00. DESIGNED BY OTHERS. SEE SHEET 8 FOR DESIGN.
10. CONTRACTOR SHALL FIELD VERIFY IF TOE DRAIN HAS BEEN INSTALLED. IF TOE DRAIN HAS BEEN INSTALLED, VERIFY INSTALLATION IS PER SPECIFICATIONS OF THE JUNE 2, 1994 GEOTECHNICAL EVALUATION OF THE NORTHWOOD POND BY HOWARD CONSULTANTS. IF THE TOE DRAIN IS NOT PRESENT IT NEEDS TO BE INSTALLED PER SPECIFICATIONS. SEE DETAIL 5 SHEET 7A.
11. EXISTING 24" CMP OUTLET IE=2189.75. CONTRACTOR SHALL INSTALL WSDOT TYPE 2 INLET PER WSDOT STANDARD DETAIL B-4C RIM EL=2196.67 AND CONNECT TO EXISTING OUTLET.
12. EXISTING 24" CMP INLET.

GENERAL NOTES

1. AT LEAST 5 FEET OF UNDISTURBED GROUND MUST BE PROVIDED BETWEEN THE EXISTING FENCE AND NEW POND GRADING.
2. THE SOUTHEAST OR DOWN-GRADIENT SIDE OF THE POND CANNOT BE RE-GRADED OR DISTURBED.
3. THE POND BOTTOM MUST BE SEEDED PER SEED MIX SHEET 6A AFTER CONSTRUCTION ACTIVITIES.
4. CONTRACTOR SHALL REMOVE EXISTING SOIL UNTIL SAND IS EXPOSED. ONCE SAND IS EXPOSED THEN FILL POND BOTTOM TO CORRECT ELEVATION (2196).
5. CONTRACTOR IS TO PLACE ALL FILL LOOSELY AND FLOOD POND AFTER PLACING THE FILL. THE POND SHOULD THEN BE RE-LEVELLED AND SEEDED.

UNDERGROUND SERVICE ALERT  
ONE-CALL NUMBER  
**456-8000**  
CALL TWO BUSINESS DAYS BEFORE YOU DIG

Associates, Inc.  
Planning  
Engineering  
Architecture  
Landscape Architecture  
Land Surveying  
707 W. 7th Avenue, Suite 200  
Spokane, WA 99204  
Phone: (509) 456-8840  
Fax: (509) 456-8844

JOHN FRANK SAYWERS  
REGISTERED PROFESSIONAL ENGINEER  
36212  
EXPIRES 5/18/04

PREPARED UNDER THE DIRECT SUPERVISION OF JOHN F. SAYWERS, P.E. WASHINGTON REGISTRATION NO. 36212 FOR AND ON BEHALF OF CLC ASSOCIATES, INC.




CLC Job Number: S000588  
Drawn By: SKM, SMM  
Designed By: SKM  
Checked By: TRW  
8-26-04 RECORD DRAWING  
By STI Northwest, Inc.

THESE PLANS ARE INSTRUMENTS OF PROFESSIONAL SERVICE AND ARE PROTECTED BY COMMON LAW, STATUTE AND OTHER LEGISLATIVE RIGHTS INCLUDING COPYRIGHT. THEY MAY NOT BE REPRODUCED OR USED FOR ANY PURPOSE WITHOUT THE WRITTEN CONSENT OF CLC ASSOCIATES, INC. (AN AFFILIATE OF COLORADO LAND CONSULTANTS, INC.)


STREET AND DRAINAGE CONSTRUCTION PLANS  
BLUE FOX - WOODLAND ESTATES PUD  
DRAINAGE DETAILS-CONTINGENCY PLAN  
SPOKANE COUNTY, WA

Sheet Title  
DETAIL SHEET  
6A OF 10  
Street Number

RECORD DRAWING

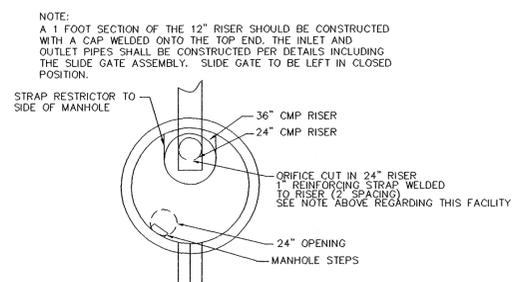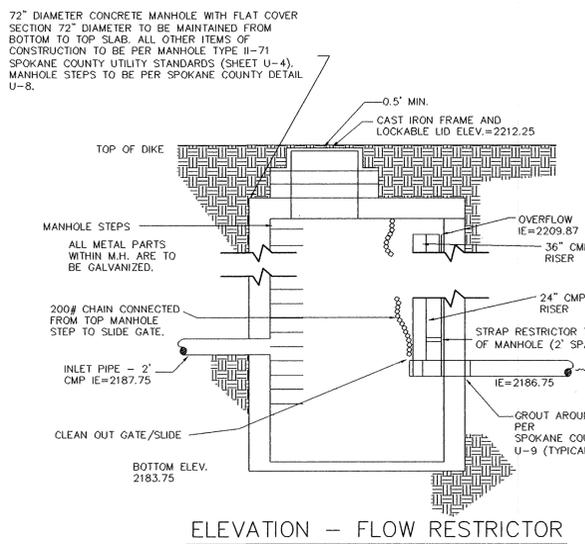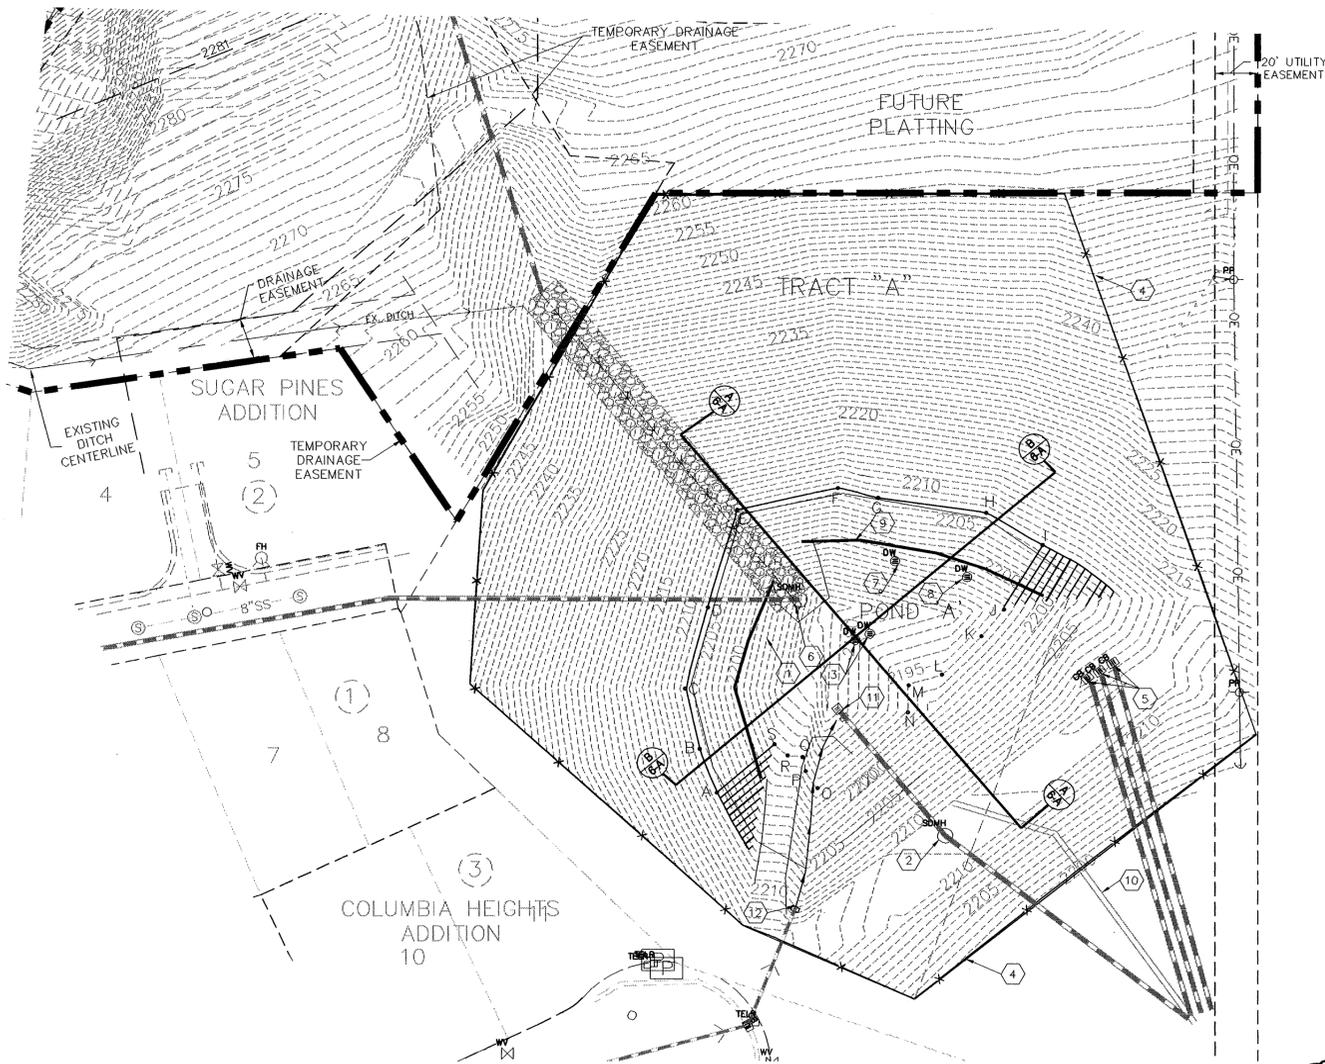

TOP VIEW - FLOW RESTRICTOR

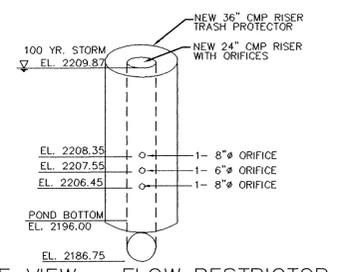

SIDE VIEW - FLOW RESTRICTOR

EXISTING FLOW RESTRICTOR MANHOLE

NOT TO SCALE


POND 'A'

SCALE: 1"=40'  
POND BOTTOM ELEV = 2196  
POND BOTTOM AREA = 14,980 SQ FT  
PERIMETER = 517.00 L.F.  
REQUIRED '208' VOLUME = 6,305 CF  
PROVIDED '208' VOLUME = 10,037 CF (8" DEPTH)

POND BOTTOM LOCATION TABLE (VISTA PARK DRIVE, STATION & OFFSET)		
POINT	STATION	OFFSET
A	11+20.77	497.61' RT.
B	11+28.96	478.50' RT.
C	11+42.47	458.39' RT.
D	11+70.46	440.31' RT.
E	12+05.07	423.80' RT.
F	12+32.32	455.99' RT.
G	12+37.49	474.03' RT.
H	12+54.25	519.54' RT.
I	12+55.73	549.80' RT.
J	12+30.30	552.16' RT.

POND BOTTOM LOCATION TABLE (VISTA PARK DRIVE, STATION & OFFSET)		
POINT	STATION	OFFSET
K	12+18.50	550.77' RT.
L	12+00.06	546.45' RT.
M	11+90.47	538.35' RT.
N	11+82.86	544.26' RT.
O	11+43.63	532.77' RT.
P	11+45.74	523.47' RT.
Q	11+48.92	518.28' RT.
R	11+46.17	512.32' RT.
S	11+46.44	504.24' RT.

POND BOTTOM DIMENSION TABLE		POND BOTTOM DIMENSION TABLE	
POINTS	LENGTH	POINTS	LENGTH
A-B	22.02'	M-N	13.10'
B-C	29.22'	N-O	55.14'
C-D	39.65'	O-P	9.73'
D-E	47.89'	P-Q	6.76'
E-F	47.95'	Q-R	7.04'
F-G	19.30'	R-S	8.63'
G-H	50.78'	S-A	35.19'
H-I	30.32'		
I-J	35.20'		
J-K	16.37'		
K-L	25.98'		
L-M	16.25'		

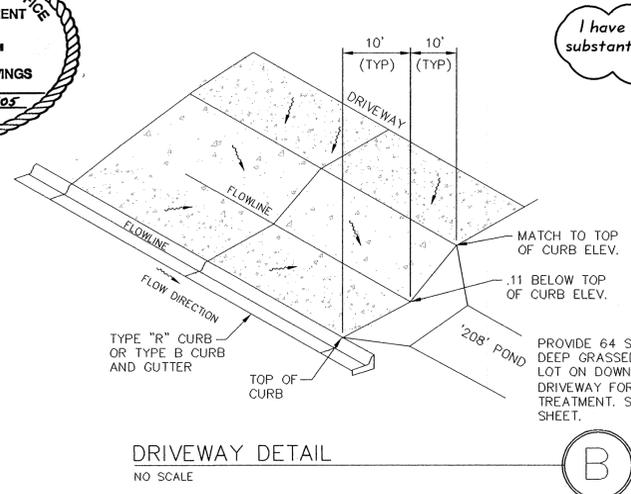


DRIVEWAY DETAIL  
NO SCALE

I have reviewed the construction and to my knowledge find it to be in substantial conformance with the approved certified plans and Standard Specifications except as noted.



NOT FOR INITIAL CONSTRUCTION

NAVD 88 DATUM  
ESTABLISHED ON-SITE BY GPS  
SURVEY PERFORMED 11/21/00  
BASED ON WSDOT MONUMENTS  
GP 32290-143 AND GP 33290-147

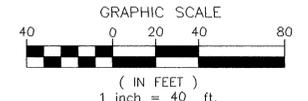

DEVELOPER'S APPROVAL \_\_\_\_\_ DATE \_\_\_\_\_

P.1729 H End As Built

# RECORD DRAWING



EXPIRES 5/18/04

PREPARED UNDER THE DIRECT SUPERVISION OF JOHN F. SAYERS, P.E. WASHINGTON REGISTRATION NO. 36212 FOR AND ON BEHALF OF CLC ASSOCIATES, INC.

RECORD DRAWING by STI Northwest, Inc.


CLC Job Number: S000588  
Drawn By: SKM, SMM  
Designed By: SKM  
Checked By: JFS

THESE PLANS ARE INSTRUMENTS OF PROFESSIONAL SERVICE AND ARE PROTECTED BY COMMON LAW, STATUTORY AND OTHER RESERVED RIGHTS INCLUDING COPYRIGHT. THEY MAY NOT BE REPRODUCED OR USED FOR ANY PURPOSES WITHOUT THE WRITTEN CONSENT OF CLC ASSOCIATES, INC. (AN AFFILIATE OF COLORADO LAND CONSULTANTS, INC.)

STREET AND DRAINAGE CONSTRUCTION PLANS  
BLUE FOX - WOODLAND ESTATES PUD  
DRAINAGE DETAILS  
SPOKANE COUNTY, WA



Sheet Title  
DETAIL SHEET

7 OF 10  
Sheet Number

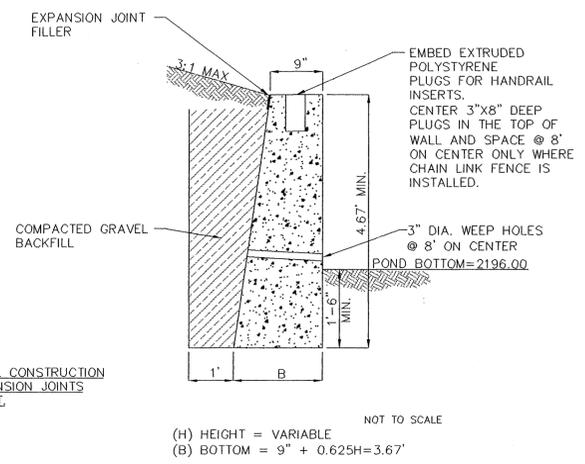


NOTE:  
SEE DETAIL CONSTRUCTION AND EXPANSION JOINTS THIS SHEET.

NOT TO SCALE  
(H) HEIGHT = VARIABLE  
(B) BOTTOM = 9" + 0.625H = 3.67'

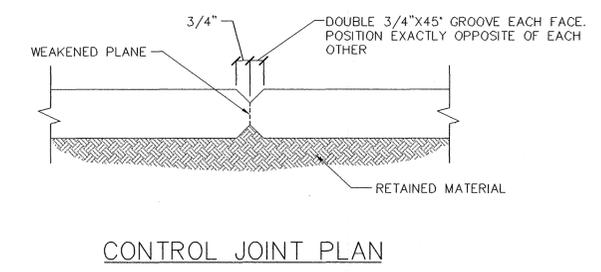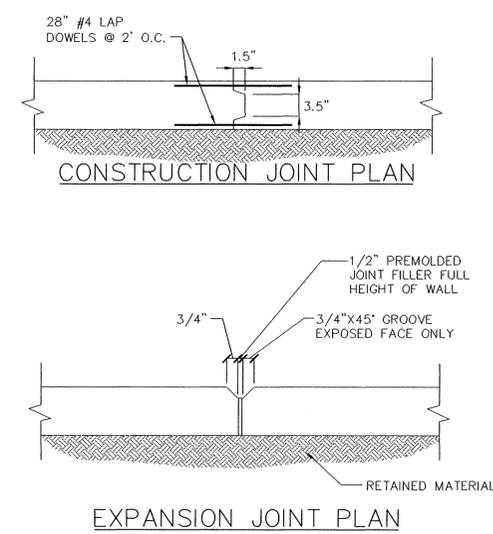

## RETAINING WALL

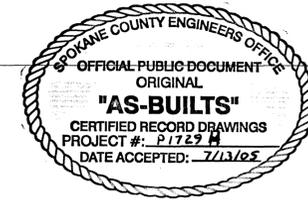


4

I have reviewed the construction and to my knowledge find it to be in substantial conformance with the approved certified plans and Standard Specifications except as noted.




NOTE:  
DUE TO THE PROPOSAL TO UTILIZE 8 INCHES VERSUS 6 INCHES OF PONDED WATER QUALITY TREATMENT DEPTH BETWEEN THE POND BOTTOM AND DRYWELL RIM ELEVATION, PRIOR TO FINAL CERTIFICATION OF THESE ROAD AND DRAINAGE FACILITIES, CATION EXCHANGE CAPACITY (CEC) TESTING WILL NEED TO BE PERFORMED ACCORDING TO THE PROCEDURE AS DESCRIBED ON PAGE 5-5 OF THE SPOKANE COUNTY GUIDELINES FOR STORMWATER MANAGEMENT. SHOULD THE CEC RESULTS INDICATE THAT THE SOIL IS NOT SUITABLE FOR STORMWATER TREATMENT, THE DESIGN ENGINEER HAS TWO OPTIONS: 1) REVISE AND RESUBMIT THE ROAD AND DRAINAGE PLANS, INDICATING THAT THE REQUIRED POND BOTTOM AREA (NECESSARY TO ACHIEVE THE REQUIRED 208 VOLUME BASED UPON A 6" DEPTH) IS PROVIDED; OR 2) APPROPRIATELY AMEND THE TOP 6 INCHES OF TOPSOIL UNTIL CEC TESTING INDICATES THAT THE COMPOSITION OF THE SOIL IS SUITABLE FOR STORMWATER TREATMENT.

**\*DRYLAND GRASS SEED MIX**  
SPOKANE COUNTY PUBLIC WORKS, FEBRUARY 1998  
GRASS SEED: PROVIDE FRESH, CLEAN, NEW CROP SEED COMPLYING WITH TOLERANCE OF PURITY AND GERMINATION ESTABLISHED BY THE OFFICIAL SEED ANALYSIS OF NORTH AMERICA. PROVIDE SEED MIXTURE COMPOSED OF GRASS SPECIES AND PERCENTAGES AS FOLLOWS:  
20% ELKA PERENNIAL RYE  
20% DURAR HARD FESCUE  
45% COVAR SHEEP/FESCUE  
15% REUBENS CANADIAN BLUEGRASS  
PROVIDE MIXTURE COMPOSED OF GRASS SEED AND FERTILIZER IN PERCENTAGES AS FOLLOWS:  
GRASS SEED: 90 LBS. PER ACRE  
FERTILIZER: 16-16-16 TIMED RELEASE COMPOSITION, 300 LBS. PER ACRE  
ALL SEEDING OF SLOPES SHALL BE DONE IN ACCORDANCE WITH THE W.S.D.O.T. STANDARD SPECIFICATIONS, SEC. 8-01.

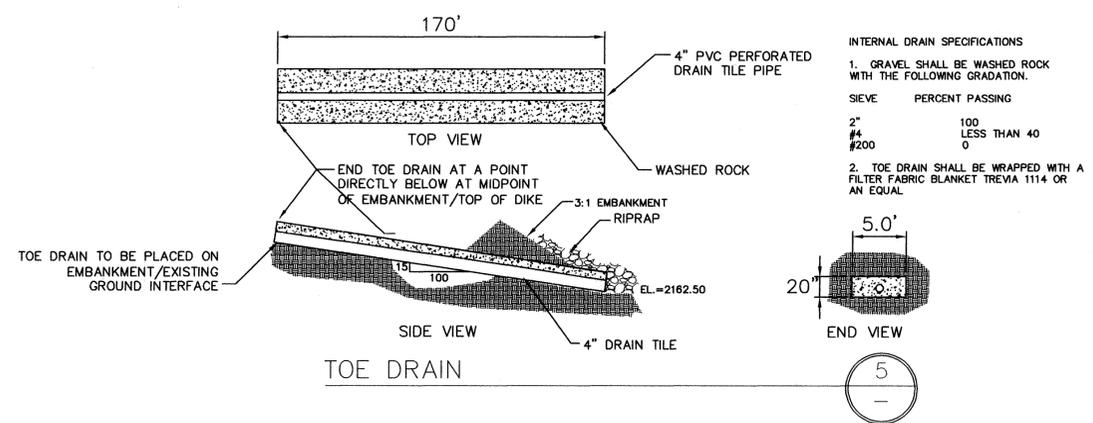


NAVD 88 DATUM  
ESTABLISHED ON-SITE BY GPS  
SURVEY PERFORMED 11/21/00  
BASED ON WSDOT MONUMENTS  
GP 32290-143 AND GP 33290-147

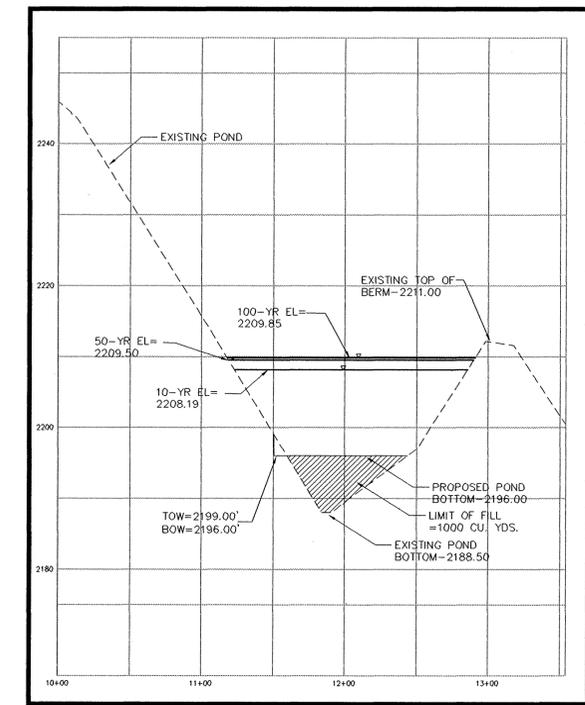

CROSS SECTION A

A

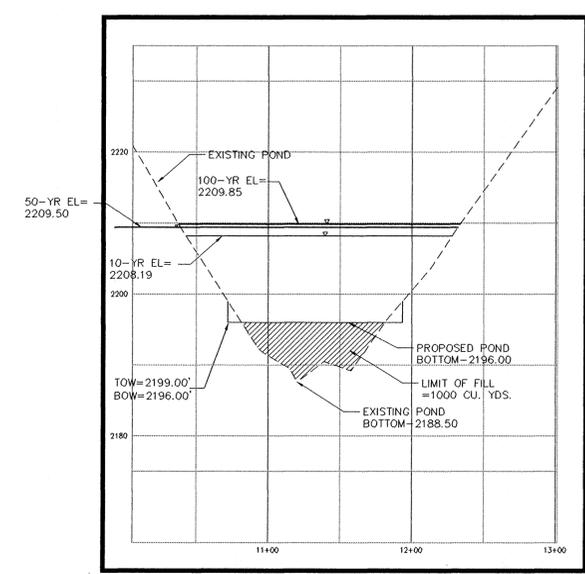

CROSS SECTION B

B


DEVELOPER'S APPROVAL \_\_\_\_\_ DATE \_\_\_\_\_

R 1729 H Pms & Build


# RECORD DRAWING

UNDERGROUND SERVICE ALERT  
ONE-CALL NUMBER  
456-8000  
CALL TWO BUSINESS DAYS  
BEFORE YOU DIG



Associates, Inc.  
Planning  
Engineering  
Architecture  
Landscape Architecture  
Land Surveying  
707 W. 7th Avenue, Suite 200  
Spokane, WA 99204  
Phone: (509) 456-8840  
Fax: (509) 456-8844

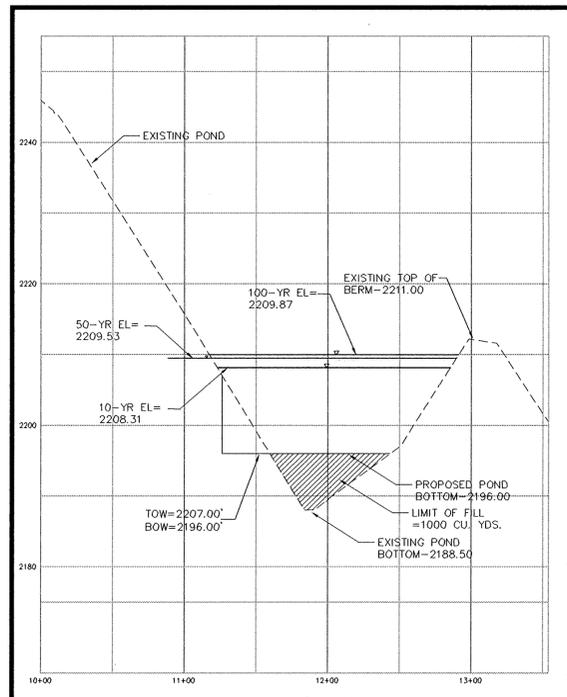

CROSS SECTION A

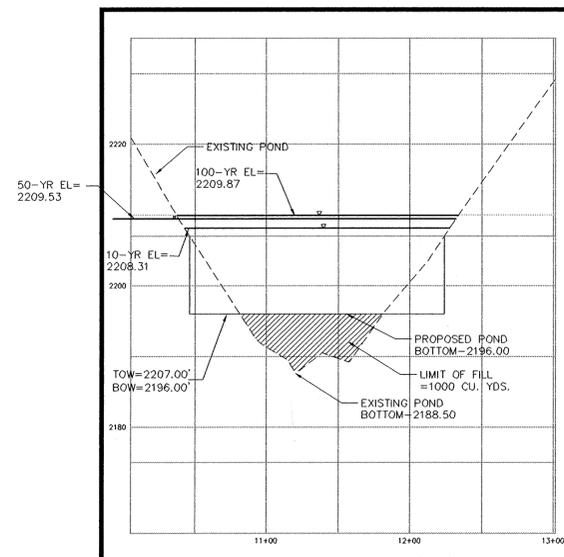

CROSS SECTION B

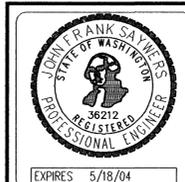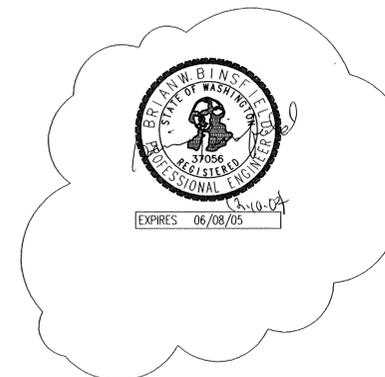

PREPARED UNDER THE DIRECT SUPERVISION OF JOHN F. SAYERS, P.E. WASHINGTON REGISTRATION NO. 36212 FOR AND ON BEHALF OF CLC ASSOCIATES, INC.

Date	Description
2/7/02	ORIGINAL PROPOSAL
05/10/02	FIRST SUBMITTAL
07/30/02	SECOND SUBMITTAL
07/23/02	THIRD SUBMITTAL
03/12/03	FIFTH SUBMITTAL
04/14/03	SIXTH SUBMITTAL
05/28/03	FINAL SUBMITTAL
8-26-04	RECORD DRAWING

by STI Northwest, Inc.

CLC Job Number: S000588  
Drawn By: SKM, SMM  
Designed By: SKM  
Checked By: JFS

THESE PLANS ARE INSTRUMENTS OF PROFESSIONAL SERVICE AND ARE PROTECTED BY COMMON LAW, STATUTE AND OTHER LEGISLATIVE RIGHTS INCLUDING COPYRIGHT. THEY MAY NOT BE REPRODUCED OR USED FOR ANY PURPOSE WITHOUT THE WRITTEN CONSENT OF CLC ASSOCIATES, INC. (AN AFFILIATE OF COLORADO LAND CONSULTANTS, INC.)

*I have reviewed the construction and to my knowledge find it to be in substantial conformance with the approved certified plans and Standard Specifications except as noted.*

**NOTE:**


DUE TO THE PROPOSAL TO UTILIZE 8 INCHES VERSUS 6 INCHES OF PONDING WATER QUALITY TREATMENT DEPTH BETWEEN THE POND BOTTOM AND DRYWELL RIM ELEVATION, PRIOR TO FINAL CERTIFICATION OF THESE ROAD AND DRAINAGE FACILITIES, CATION EXCHANGE CAPACITY (CEC) TESTING WILL NEED TO BE PERFORMED ACCORDING TO THE PROCEDURE AS DESCRIBED ON PAGE 5-5 OF THE SPOKANE COUNTY GUIDELINES FOR STORMWATER MANAGEMENT. SHOULD THE CEC RESULTS INDICATE THAT THE SOIL IS NOT SUITABLE FOR STORMWATER TREATMENT, THE DESIGN ENGINEER HAS TWO OPTIONS: 1) REVISE AND RESUBMIT THE ROAD AND DRAINAGE PLANS, INDICATING THAT THE REQUIRED POND BOTTOM AREA (NECESSARY TO ACHIEVE THE REQUIRED 208 VOLUME BASED UPON A 6" DEPTH) IS PROVIDED; OR 2) APPROPRIATELY AMEND THE TOP 6 INCHES OF TOPSOIL UNTIL CEC TESTING INDICATES THAT THE COMPOSITION OF THE SOIL IS SUITABLE FOR STORMWATER TREATMENT.

**\*DRYLAND GRASS SEED MIX**

SPOKANE COUNTY PUBLIC WORKS, FEBRUARY 1998  
GRASS SEED: PROVIDE FRESH, CLEAN, NEW CROP SEED COMPLYING WITH TOLERANCE OF PURITY AND GERMINATION ESTABLISHED BY THE OFFICIAL SEED ANALYSIS OF NORTH AMERICA. PROVIDE SEED MIXTURE COMPOSED OF GRASS SPECIES AND PERCENTAGES AS FOLLOWS:  
 20% ELKA PERENNIAL RYE  
 20% DURAR HARD FESCUE  
 45% COVAR SHEEP/FESCUE  
 15% REUBENS CANADIAN BLUEGRASS

PROVIDE MIXTURE COMPOSED OF GRASS SEED AND FERTILIZER IN PERCENTAGES AS FOLLOWS:  
 GRASS SEED: 90 LBS. PER ACRE  
 FERTILIZER: 16-16-16 TIMED RELEASE COMPOSITION, 300 LBS. PER ACRE

ALL SEEDING OF SLOPES SHALL BE DONE IN ACCORDANCE WITH THE W.S.D.O.T. STANDARD SPECIFICATIONS, SEC. 8-01.

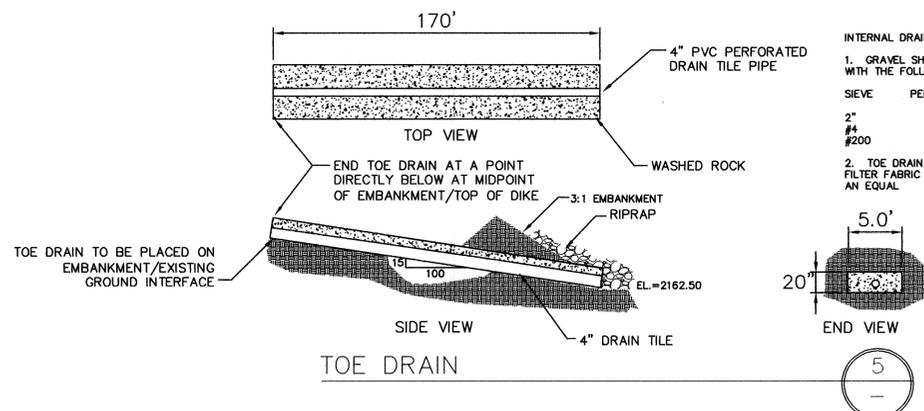

NAVD 88 DATUM  
ESTABLISHED ON-SITE BY GPS  
SURVEY PERFORMED 11/21/00  
BASED ON WSDOT MONUMENTS  
GP 32290-143 AND GP 33290-147

**NOT FOR INITIAL CONSTRUCTION**

DEVELOPER'S APPROVAL \_\_\_\_\_

DATE \_\_\_\_\_

STREET AND DRAINAGE CONSTRUCTION PLANS  
BLUE FOX - WOODLAND ESTATES PUD  
DRAINAGE DETAILS-CONTINGENCY PLAN  
SPOKANE COUNTY, WA


Sheet Title  
DETAIL SHEET  
7A OF 10  
Sheet Number

P-1729H Eng. As Built

L	A	B	C	D	E	F	G	H	J
8'-0"	8"	4'-6"	3'-4"	6"	#5@18	#5@18	#5@18	2#5	2#5
11'-0"	10"	6'-6"	5'-2"	6"	#5@15	#6@15	#6@15	3#5	3#5

UNDERGROUND SERVICE ALERT  
ONE-CALL NUMBER  
456-8000  
CALL TWO BUSINESS DAYS  
BEFORE YOU DIG

Associates, Inc.  
Planning  
Engineering  
Architecture  
Landscape Architecture  
Land Surveying  
707 W. 7th Avenue, Suite 200  
Spokane, WA 99204  
Phone: (509) 458-8840  
Fax: (509) 458-8844

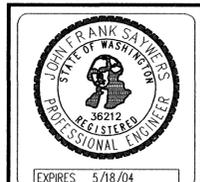

PREPARED UNDER THE DIRECT  
SUPERVISION OF  
JOHN F. SAYWERS, P.E.  
WASHINGTON REGISTRATION  
NO. 36212  
FOR AND ON BEHALF OF  
CLC ASSOCIATES, INC.


Description  
ORIGINAL PROPOSAL  
FIRST SUBMITTAL  
RECORD DRAWING  
by STI Northwest, Inc.  
Date  
2/1/02  
05/15/03  
8-26-04

CLC Job Number: S000588  
Drawn By: SKM, SMM  
Designed By: SKM  
Checked By: TRW  
THESE PLANS ARE INSTRUMENTS OF PROFESSIONAL  
SERVICE AND ARE PROTECTED BY COMMON LAW,  
STATUTE AND OTHER RESERVED RIGHTS INCLUDING  
COPYRIGHT. THEY MAY NOT BE REPRODUCED OR  
USED FOR ANY PURPOSE WITHOUT THE WRITTEN  
CONSENT OF CLC ASSOCIATES, INC. (AN AFFILIATE  
OF COLORADO LAND CONSULTANTS, INC.)

STREET AND DRAINAGE CONSTRUCTION PLANS  
BLUE FOX - WOODLAND ESTATES PUD  
RETAINING WALL - CONTINGENCY PLAN  
SPOKANE COUNTY, WA

Sheet Title  
DETAIL SHEET  
8 OF 10  
Sheet Number


# RECORD DRAWING

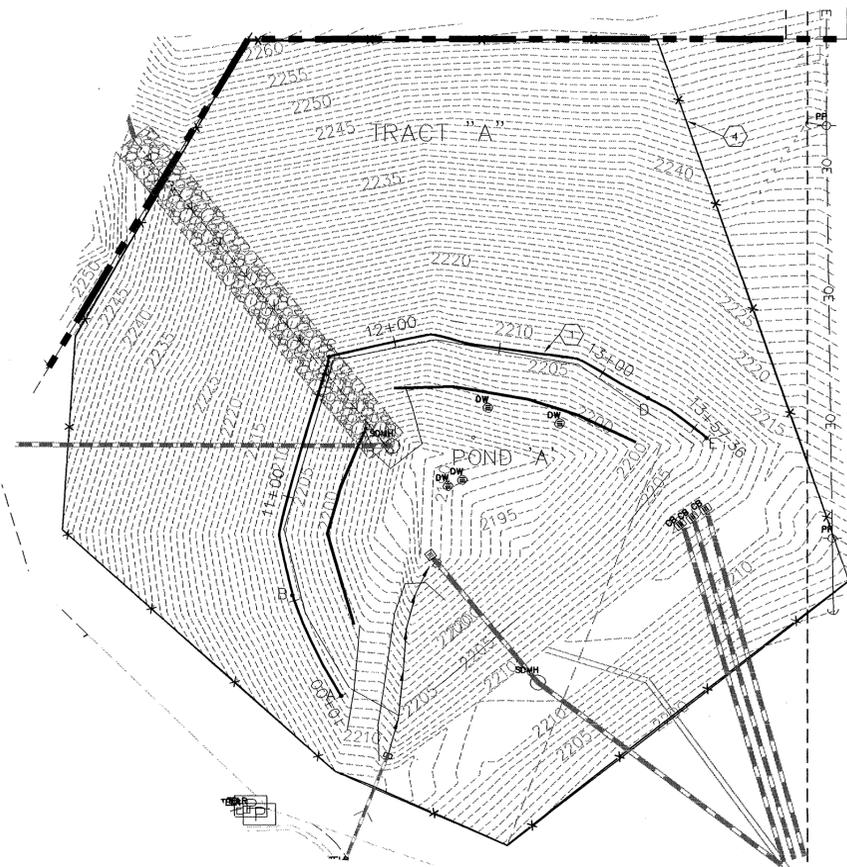

POND 'A'  
SCALE: 1"=40'

WALL ORIENTATION  
(VISTA PARK DRIVE, STATION & OFFSET)

POINT	STATION	OFFSET
A	11+12.40	526.03' RT.
B	11+28.96	478.50' RT.
C	12+04.75	423.70' RT.
D	12+56.28	556.31' RT.
E	12+55.91	589.49' RT.

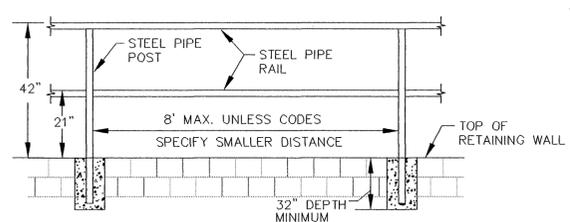

- NOTES:
1. ENDS SHALL BE RETURNED OR SHALL TERMINATE IN NEWEL POSTS OR SAFETY TERMINALS. THE HANDGRIP PORTION OF HANDRAILS SHALL BE NOT LESS THAN 1-1/2" (INCHES) NOR MORE THAN 2" (INCHES) IN CROSS-SECTIONAL DIMENSION OR THE SHAPE SHALL PROVIDE AN EQUIVALENT GRIPPING SURFACE. THE HANDGRIP PORTION OF HANDRAILS SHALL HAVE A SMOOTH SURFACE WITH NO SHARP CORNERS. THE HANDGRIP PORTION OF HANDRAILS ON MAIN LEVEL SHALL BE A MINIMUM OF 42" (INCHES) HIGH TO THE TOP RAIL WITH INTERMEDIATE RAIL AT THE MID POINT OF THE HEIGHT OF HANDRAIL. CONTRACTOR SHALL ENSURE THAT THE RAILING MEET OR EXCEEDS CURRENT U.B.C. REQUIREMENTS.
  2. PAINT ALL STEEL PIPE RAILINGS AND POSTS.
  3. PIPES SHALL BE WELDED TOGETHER IN ACCORDANCE WITH CURRENT U.B.C. REQUIREMENTS.
  4. PIPE DIMENSIONS SHALL MEET OR EXCEED CURRENT U.B.C. REQUIREMENTS.


HANDRAIL FOR RETAINING WALL  
SCALE: 1"=40'





## CONSTRUCTION NOTES

1. CONSTRUCT POURED IN PLACE CONCRETE REINFORCED RETAINING WALL, SEE SECTION 3, THIS SHEET.
2. INSTALL 42-INCH HIGH HANDRAIL, ALONG THE ENTIRE TOP OF WALL. SEE DETAIL 4, THIS SHEET.
3. PLACE 2-INCH DIA. PVC SLEEVES FOR DRAINAGE PORTS, AT 8-FOOT HORIZONTAL, CENTERED IN EACH 8 FT. WIDE PANEL.
4. 24-INCH WIDE SECTION OF DRAINAGE GRAVEL PER GEOTECHNICAL REPORT.


I have reviewed the construction and to my knowledge find it to be in substantial conformance with the approved certified plans and Standard Specifications except as noted.

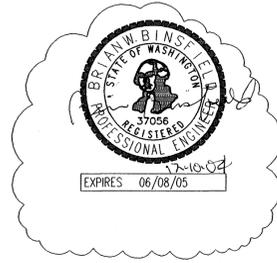


NOTES:  
CONCRETE: 3000 PSI @ 28 DAYS = Fc  
REINF: ASTM A615 GR. 60  
ALLOW. SOIL PRESSURE = 3000 PSI  
SPECIAL INSPECTION REQUIRED  
EQUIV. SOIL FLUID PRESSURE: 30 PSF  
SUBMIT REINFORCING SHOP DRAWINGS FOR APPROVAL.

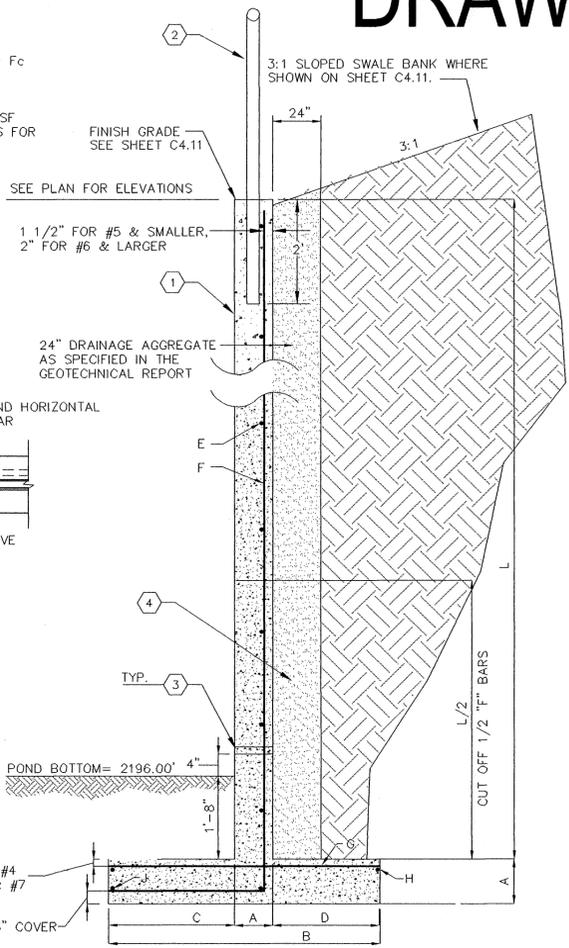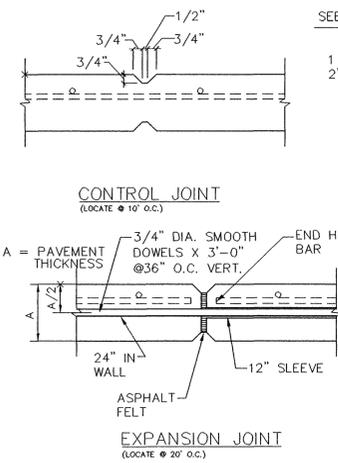

TYPICAL RETAINING WALL SECTION  
NOT TO SCALE

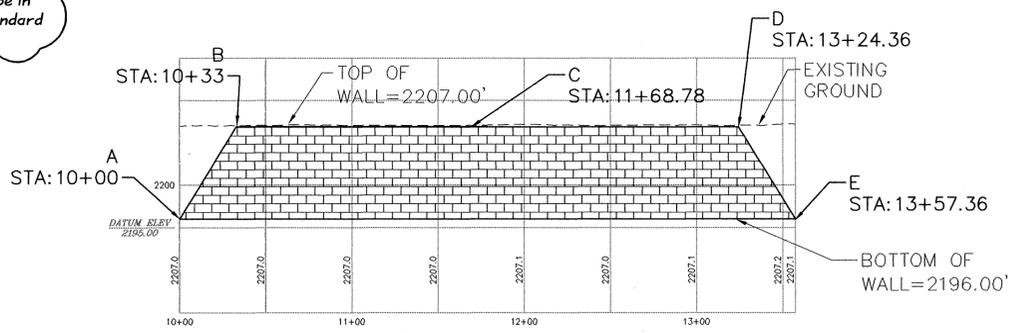

RETAINING WALL PROFILE

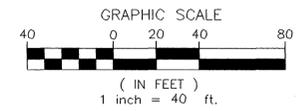

**NOT FOR INITIAL CONSTRUCTION**

NAVD 88 DATUM  
ESTABLISHED ON-SITE BY GPS  
SURVEY PERFORMED 11/21/00  
BASED ON WSDOT MONUMENTS  
GP 32290-143 AND GP 33290-147

DEVELOPER'S APPROVAL \_\_\_\_\_ DATE \_\_\_\_\_

P.1729M  
Ena A. Built


# BLUE FOX - WOODLAND ESTATES PUD

## EROSION CONTROL PLAN

NE 1/4 SECTION 31, T.26 N., R44 E., W.M.  
SPOKANE COUNTY, WASHINGTON

# RECORD DRAWING

Associates, Inc.  
Planning  
Engineering  
Architecture  
Landscape Architecture  
Land Surveying  
707 W. 7th Avenue, Suite 200  
Spokane, WA 99204  
Phone: (509) 458-8840  
Fax: (509) 458-8844

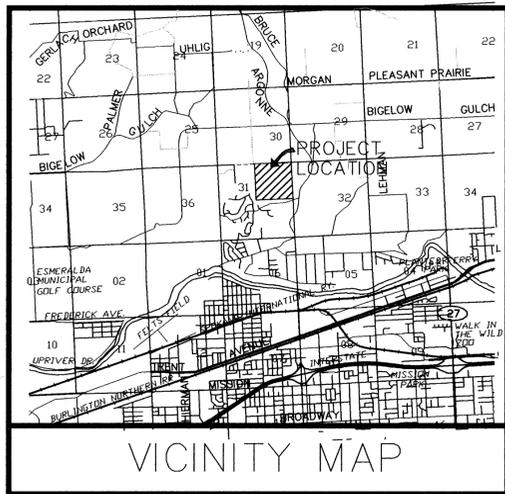

### EROSION & SEDIMENT CONTROL

#### GENERAL NOTES AND INFORMATION

1. AN EROSION/SEDIMENT CONTROL (ESC) PLAN IS REQUIRED FOR THIS PROJECT. IMPLEMENTATION OF THE ESC PLAN, AND CONSTRUCTION, MAINTENANCE, AND UPGRADING OF THE ESC FACILITIES ARE THE RESPONSIBILITY OF THE DEVELOPER UNTIL ALL CONSTRUCTION IS COMPLETED AND ACCEPTED BY SPOKANE COUNTY, OR UNTIL VEGETATION IS ESTABLISHED THROUGHOUT THE SITE, AND ACCEPTED BY SPOKANE COUNTY, WHICHEVER IS LATER.
2. APPROVAL OF THE ESC PLAN DOES NOT CONSTITUTE APPROVAL OF ANY OF THE PROPOSED ROAD, STORM DRAINAGE, GRADING OR UTILITY DESIGN ELEMENTS SHOWN ON THE ESC PLAN.
3. THE EROSION/SEDIMENT CONTROL MEASURES SHOWN ARE THE MINIMUM REQUIREMENTS FOR THE ANTICIPATED SITE CONDITIONS. THE CONTRACTOR SHALL INSPECT AND MAINTAIN THESE ESC MEASURES DAILY, AND SHALL MAINTAIN AND UPGRADE THESE MEASURES AS NECESSARY TO PREVENT SEDIMENT-LADEN WATER FROM EITHER FLOWING OFF SITE, OR INTO NEW/EXISTING STORM DRAINAGE FACILITIES, SUCH AS DRYWELLS, CULVERTS, OR GRAVEL GALLERIES.
4. GEOTEXTILE FABRIC IS TO BE PLACED ON THE RIMS OF DRYWELLS, CATCH BASINS AND INLETS UNTIL SUCH TIME THAT THE VEGETATION ON THE SITE IS ESTABLISHED AND THE THREAT OF SEDIMENT DEPOSITION INTO THE DRAINAGE SYSTEM IS MITIGATED.
5. THE SILT FENCES SHALL BE INSTALLED BY THE CONTRACTOR PRIOR TO OTHER SITE WORK, AND MAINTAINED THROUGHOUT THE DURATION OF CONSTRUCTION.
6. THE CONTRACTOR IS RESPONSIBLE FOR INSTALLING ROCK CONSTRUCTION ENTRIES AT ANY AND ALL LOCATIONS USED TO ENTER OR EXIT THE PROJECT SITE. SEE DETAIL (CE).
7. THE CONTRACTOR IS RESPONSIBLE FOR DESIGNATING A LOCATION WHERE CONCRETE TRUCKS AND EQUIPMENT CAN BE WASHED OUT, NOT LOCATED NEAR OR DRAINING INTO A STORM DRAINAGE AREA.
8. PROPERTY OWNER: NORTHWOOD PROPERTIES, INC., THEODORE G. GUNNING, PRESIDENT (509) 624-7950. PERMIT APPLICANT: NORTHWOOD PROPERTIES, INC., THEODORE G. GUNNING, PRESIDENT (509) 624-7950. CONTACT PERSON ON SITE: GARY GUNNING, CONTRACTOR (509) 951-9786.
9. PROJECT LOCATION: IN WOODLAND ESTATES, WEST OF AND ADJACENT TO VISTA PARK DRIVE, NORTH OF COLUMBIA DRIVE AND SOUTH OF BIGELOW GULCH, IN THE NE 1/4 OF SECTION 31, TOWNSHIP 26 N., RANGE 44 E.W.M., SPOKANE COUNTY.
10. PROJECT DESCRIPTION: BLUE FOX - WOODLAND ESTATES IS A RESIDENTIAL SUBDIVISION CONSISTING OF 22 LOTS AND WILL REQUIRE CONSTRUCTION OF A PRIVATE ROAD, STORM DRAINAGE AND ELECTRICAL FACILITIES. THE IMPROVEMENTS CONSIST OF APPROXIMATELY 1,900 LINEAR FEET OF NEW PRIVATE STREETS, CURBS, AND ASSOCIATED STORM DRAINAGE FACILITIES AND DITCHES.
11. DESCRIPTION OF ESC MEASURES: USE OF SILT FENCES AND ROCK CONSTRUCTION ENTRANCES AS SHOWN ON PLAN. ALL ESC MEASURES MENTIONED ABOVE ARE TEMPORARY AND WILL BE REMOVED AFTER YARDS ARE LANDSCAPED.
12. EXISTING VEGETATION: PREDOMINANTLY FIELD GRASS.
13. PLAN PREPARATION DATE: FEBRUARY 27, 2001
14. SOILS: ON SITE SOILS INCLUDE BERNHILL SILT LOAM (Bbb); AND SPOKANE VERY ROCKY COMPLEX (Sic).
15. STABILIZATION OF DENUDED AREAS: ANY DISTURBED AREAS, WHICH WOULD BE LEFT BARE FOR MORE THAN 7 DAYS AND ARE NOT INTENDED TO BE REWORKED WITHIN 30-45 DAYS SHALL BE SEEDING WITH A FAST STARTING NATIVE DRYLAND GRASS SUCH AS ANNUAL RYE, OR APPROVED EQUAL, AT A RATE OF 60 lbs/ACRE.
16. SURFACE ROUGHENING: ALL SLOPES STEEPER THAN 3:1 AND GREATER THAN 5 VERTICAL FEET AS SHOWN ON PLAN AND ALL UNVEGETATED SLOPES SHALL BE MECHANICALLY SCARIFIED AS SHOWN ON DETAIL SR PRIOR TO SEEDING.
17. CONTROL OF POLLUTANTS: ANY SPILLS WILL BE HANDLED ACCORDING TO D.O.E. AND D.O.H. GUIDELINES



PREPARED UNDER THE DIRECT SUPERVISION OF JOHN F. SAWYERS, P.E. WASHINGTON REGISTRATION NO. 36212 FOR AND ON BEHALF OF CLC ASSOCIATES, INC.

Date	Description
02/27/01	PRELIMINARY SUBMITTAL
03/05/03	SECTION 1 SUBMITTAL
03/12/03	SECTION 2 SUBMITTAL
05/28/03	FINAL SUBMITTAL
8-26-04	RECORD DRAWING by STI Northwest, Inc.


Project Number: S000588  
CLC Job Number: S000588  
Drawn By: EMT, SMM  
Designed By: EMT  
Checked By: JFS  
THESE PLANS ARE INSTRUMENTS OF PROFESSIONAL SERVICE AND ARE PROVIDED BY COMMON LAW, STATUTE AND OTHER RESERVED RIGHTS INCLUDING COPYRIGHT. THEY MAY NOT BE REPRODUCED OR USED FOR ANY PURPOSE WITHOUT THE WRITTEN CONSENT OF CLC ASSOCIATES, INC. (AN AFFILIATE OF COLORADO LAND CONSULTANTS, INC.)

EROSION AND SEDIMENT CONTROL  
BLUE FOX - WOODLAND ESTATES PUD  
EROSION COVER  
SPOKANE COUNTY, WASHINGTON

Sheet Title  
EROSION AND SEDIMENT CONTROL  
9 OF 10  
Sheet Number

#### LEGAL DESCRIPTION


BEGINNING at the northwest corner of Lot 8, Block 3, SUGAR PINES-WOODLAND ESTATES P.U.D., per plat thereof recorded in Book 26 of Plats, Pages 17-18; thence along the northerly boundary of said SUGAR PINES-WOODLAND ESTATES P.U.D. the following six (6) courses: 1) N74°57'57"E 114.82 feet; 2) northeasterly along the arc of a 215.50 foot radius non-tangent curve right, the center of which bears S41°22'04"E, through a central angle of 32°43'12", an arc length of 123.07 feet; 3) N81°21'08"E 136.13 feet; 4) southeasterly along the arc of a 515.50 foot radius tangent curve right, through a central angle of 31°11'59", an arc length of 280.71 feet; 5) southeasterly along the arc of a 265.50 foot radius compound curve right, the center of which bears S22°33'07"W, through a central angle of 19°35'02", an arc length of 90.75 feet; 6) northeasterly along the arc of a 20.00 foot radius reverse curve left, the center of which bears N42°08'09"E, through a central angle of 85°18'17", an arc length of 29.78 feet; thence northeasterly along the arc of a 1415.00 foot radius compound curve left in the westerly right-of-way line of Visto Park Drive, the center of which bears N43°10'08"W, through a central angle of 08°52'00", an arc length of 218.98 feet; thence along the southerly boundary of RED OAK-WOODLAND ESTATES P.U.D., per plat thereof recorded in Book 26 of Plats, Pages 59-60, the following sixteen (16) courses: 1) southwesterly along the arc of a 20.00 foot radius non-tangent curve right, the center of which bears N52°02'09"W, through a central angle of 75°57'26", an arc length of 26.51 feet; 2) N66°04'43"W 36.96 feet; 3) westerly along the arc of a 715.50 foot radius tangent curve left, through a central angle of 32°34'09", an arc length of 406.72 feet; 4) S81°21'08"W 171.03 feet; 5) southwesterly along the arc of a 1215.50 foot radius tangent curve left, through a central angle of 05°23'07", an arc length of 114.25 feet; 6) S75°58'01"W 134.36 feet; 7) southwesterly along the arc of a 1000.50 foot radius tangent curve left, through a central angle of 07°20'04", an arc length of 128.07 feet; 8) southwesterly along the arc of a 324.50 foot radius reverse curve right, the center of which bears N21°22'03"W, through a central angle of 14°40'08", an arc length of 83.08 feet; 9) southwesterly along the arc of a 1000.50 foot radius reverse curve left, the center of which bears S06°41'55"E, through a central angle of 07°20'04", an arc length of 128.07 feet; 10) S75°58'01"W 160.76 feet; 11) southwesterly along the arc of a 165.50 foot radius tangent curve left, through a central angle of 16°08'10", an arc length of 46.61 feet; 12) S59°49'51"W 32.25 feet; 13) southwesterly along the arc of a 134.50 foot radius tangent curve right, through a central angle of 27°50'57", an arc length of 65.38 feet; 14) S87°40'48"W 37.88 feet; 15) northwesterly along the arc of a 134.50 foot radius tangent curve right, through a central angle of 37°44'50", an arc length of 88.61 feet; 16) N54°34'22"W 215.16 feet to a point on the easterly line of Lot 3, Block 1, WOODLAND PINES, per plat thereof recorded in Book 20 of Plats, Page 70; thence S23°04'05"W 146.48 feet to the southeast corner of said Lot 3, Block 1, and the northeast corner of Tract "A", COLUMBIA HEIGHTS - WOODLAND ESTATES 1ST ADDITION P.U.D., per plat thereof recorded in Book 24 of Plats, Pages 83-85; thence along the northerly boundary of said COLUMBIA HEIGHTS-WOODLAND ESTATES 1ST ADDITION P.U.D. the following eight (8) courses: 1) S03°45'18"E 29.55 feet (29.72' plat); 2) southeasterly along the arc of a 265.00 foot radius non-tangent curve right, the center of which bears S18°17'58"W, through a central angle of 49°00'18", an arc length of 226.65 feet; 3) S22°41'44"E 9.48 feet; 4) southeasterly along the arc of a 20.00 foot radius tangent curve left, through a central angle of 76°36'36", an arc length of 26.74 feet; 5) northeasterly along the arc of a 984.00 foot radius compound curve right, the center of which bears N09°18'20"W, through a central angle of 09°24'27", an arc length of 161.56 feet; 6) N71°17'13"E 21.14 feet (21.13' plat); 7) easterly along the arc of a 1532.00 foot radius tangent curve right, through a central angle of 19°42'08", an arc length of 526.80 feet; (19°42'02", 526.76' plat); 7) S89°00'39"E 95.04 feet to the southwest corner of said Lot 8, Block 3; thence N16°59'38"W 74.71 feet (74.72' plat) along the west line of said Lot 8, Block 3, to the Point of Beginning.

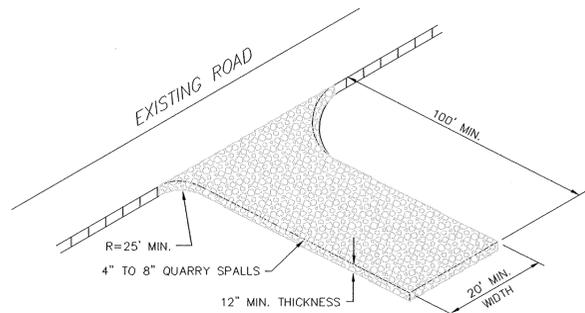


STABILIZED CONSTRUCTION ENTRANCE AND TIRE WASH

NOT TO SCALE

(CE)

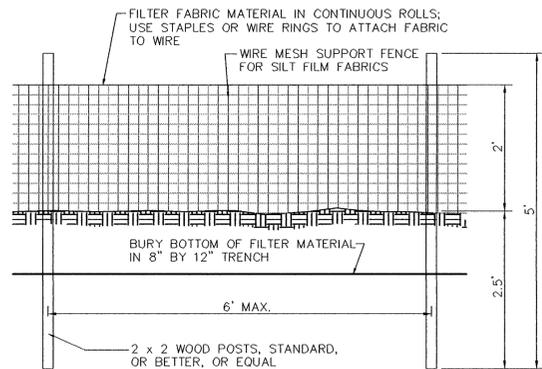

ELEVATION

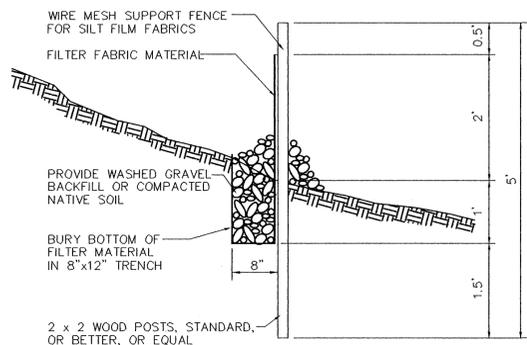


SECTION

FILTER FENCE

NOT TO SCALE

(FF)

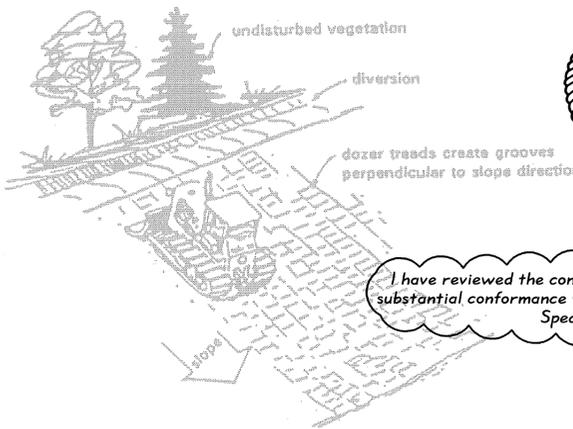

SURFACE ROUGHENING


(SR)

I have reviewed the construction and to my knowledge find it to be in substantial conformance with the approved certified plans and Standard Specifications except as noted.

CERTIFICATION STATEMENT: I CERTIFY THAT THIS EROSION AND SEDIMENT CONTROL PLAN MEETS THE ESC REQUIREMENTS AS LISTED IN CHAPTER 4.5 OF THE SPOKANE COUNTY GUIDELINES FOR STORMWATER MANAGEMENT.

TODD R. WHIPPLE

THE DESIGN IMPROVEMENTS SHOWN IN THIS SET OF PLANS AND CALCULATIONS CONFORM TO APPLICABLE EDITIONS OF THE SPOKANE COUNTY STANDARDS FOR ROAD AND SEWER CONSTRUCTION AND THE SPOKANE COUNTY GUIDELINES FOR STORMWATER MANAGEMENT. ALL DESIGN DEVIATIONS HAVE BEEN APPROVED BY THE SPOKANE COUNTY ENGINEER. I APPROVE THESE PLANS FOR CONSTRUCTION.

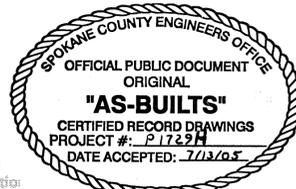

#### MAINTENANCE

1. THE CONTRACTOR SHALL BE RESPONSIBLE FOR INSTALLATION AND MAINTENANCE OF THE TEMPORARY ESC MEASURES.
2. SEDIMENT BARRIERS SHALL BE INSPECTED IMMEDIATELY AFTER EACH RUNOFF-PRODUCING RAINFALL AND AT LEAST DAILY DURING PROLONGED RAINFALL.
3. NECESSARY REPAIRS TO BARRIERS OR REPLACEMENT OF FILTER FABRIC SHALL BE ACCOMPLISHED PROMPTLY.
4. SEDIMENT DEPOSITS SHOULD BE REMOVED AFTER EACH RUNOFF-PRODUCING RAINFALL. DEPOSITS MUST BE REMOVED WHEN THE LEVEL OF DEPOSITION REACHES APPROXIMATELY 1/2 THE HEIGHT OF THE BARRIER.
5. ANY SEDIMENT DEPOSITS REMAINING IN PLACE AFTER THE ESC STRUCTURE IS NO LONGER REQUIRED SHALL BE DRESSED TO CONFORM TO THE EXISTING GRADE, PREPARED AND SEDED.
6. ALL TEMPORARY AND PERMANENT ESC PRACTICES SHALL BE MAINTAINED AND REPAIRED AS NEEDED TO ASSURE CONTINUED PERFORMANCE OF THEIR INTENDED FUNCTION.
7. ALL TEMPORARY ESC MEASURES SHALL BE REMOVED WITHIN 30 DAYS AFTER FINAL SITE STABILIZATION IS ACHIEVED OR AFTER THE TEMPORARY BMP'S ARE NO LONGER NEEDED. TRAPPED SEDIMENT SHALL BE REMOVED OR STABILIZED ON SITE. DISTURBED SOIL AREAS RESULTING FROM REMOVAL SHALL BE PERMANENTLY STABILIZED.
8. THE CONTRACTOR SHALL BE RESPONSIBLE FOR CLEANING DIRT, MUD AND OTHER CONSTRUCTION DEBRIS WHICH MAY ACCUMULATE ON PAVED STREETS ADJACENT TO THE SITE AS A RESULT OF CONSTRUCTION ACTIVITY. CLEANING SHALL BE ON AN "AS NEEDED" BASIS USING SWEEPING AND WATER TO WASH THE CONSTRUCTION DEBRIS FROM THE STREET.
9. ON-SITE DUST CONTROL SHALL BE ACCOMPLISHED BY USING WATER. APPLICATIONS OF WATER MAY BE REQUIRED SEVERAL TIMES PER DAY DURING CONSTRUCTION ACTIVITY.

#### LEGEND



- (Symbol) INLET PROTECTION - NO CONCRETE TRUCK WASHOUT. SEE GENERAL NOTES 4 AND 7.

DEVELOPER'S APPROVAL

DATE

COUNTY DATUM  
TBM ON 60d SPIKE AT STA. 24+00  
50' RT. ON NORTHWOOD DRIVE  
ELEVATION=2417.11 (NAVD-27)


P-17294 Era As Built

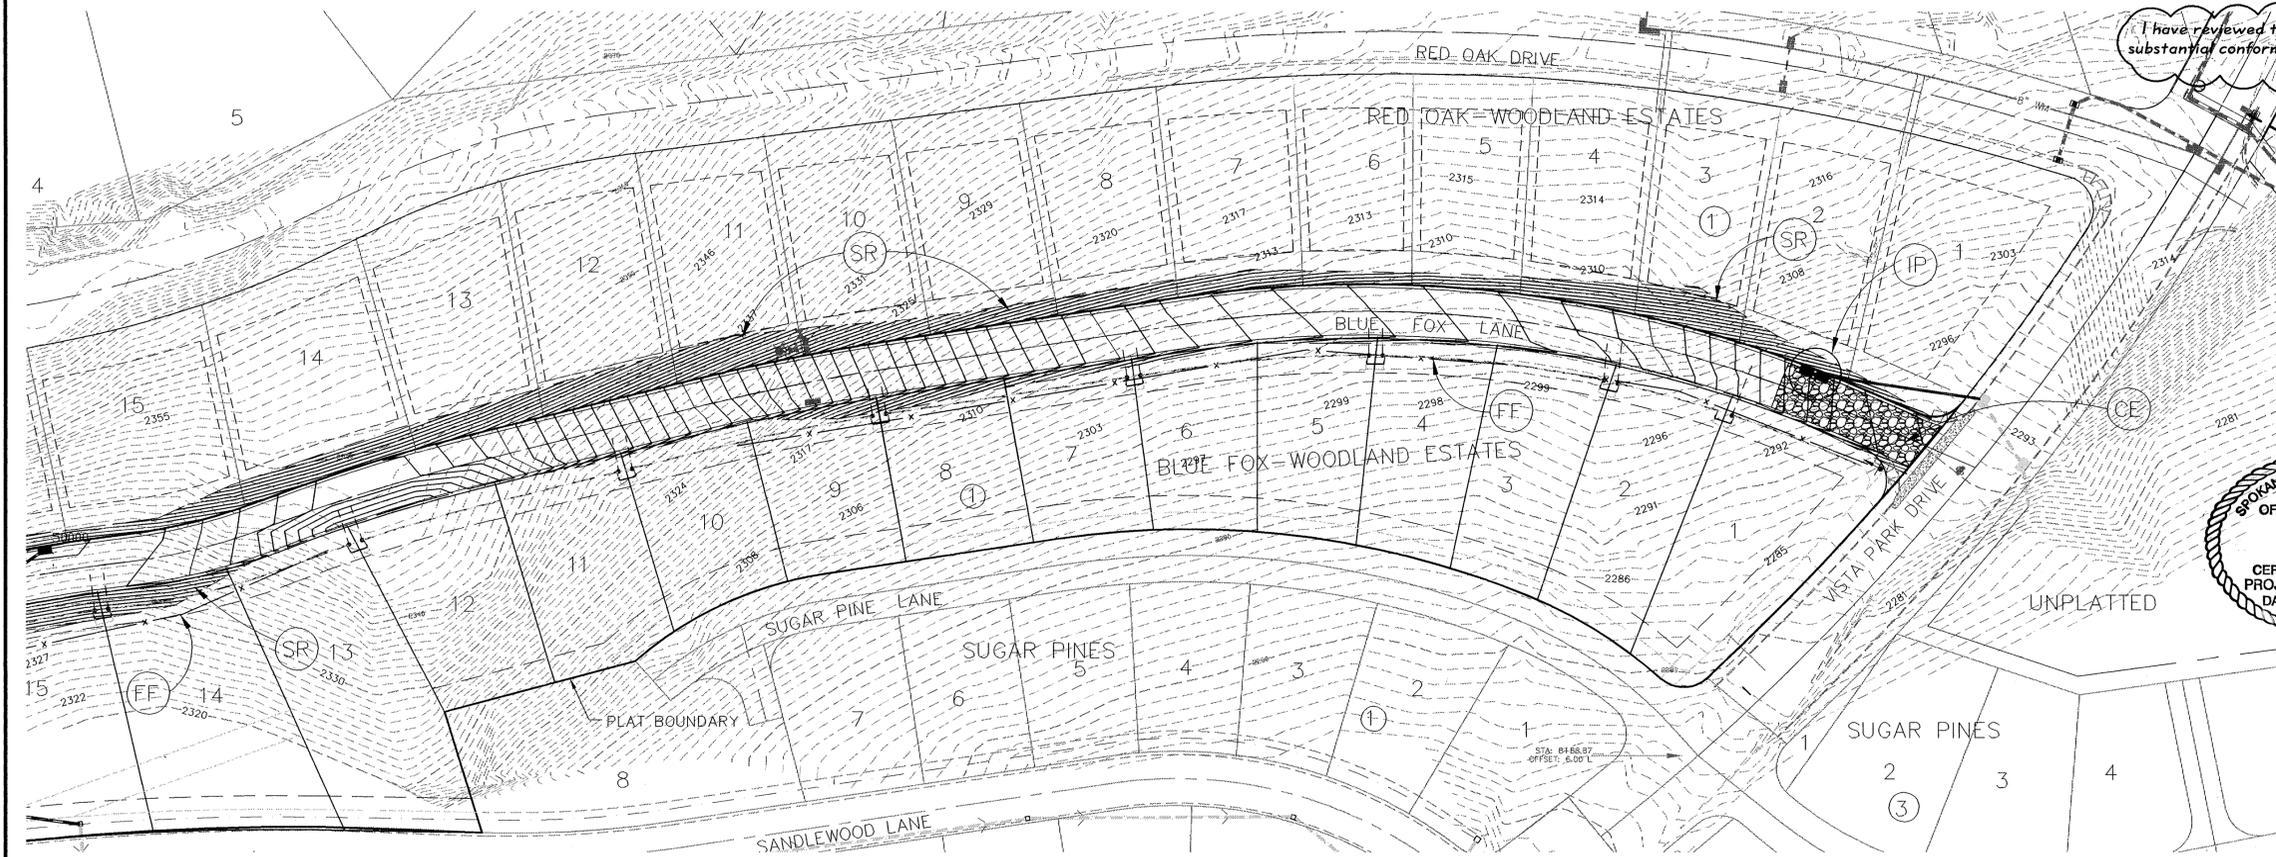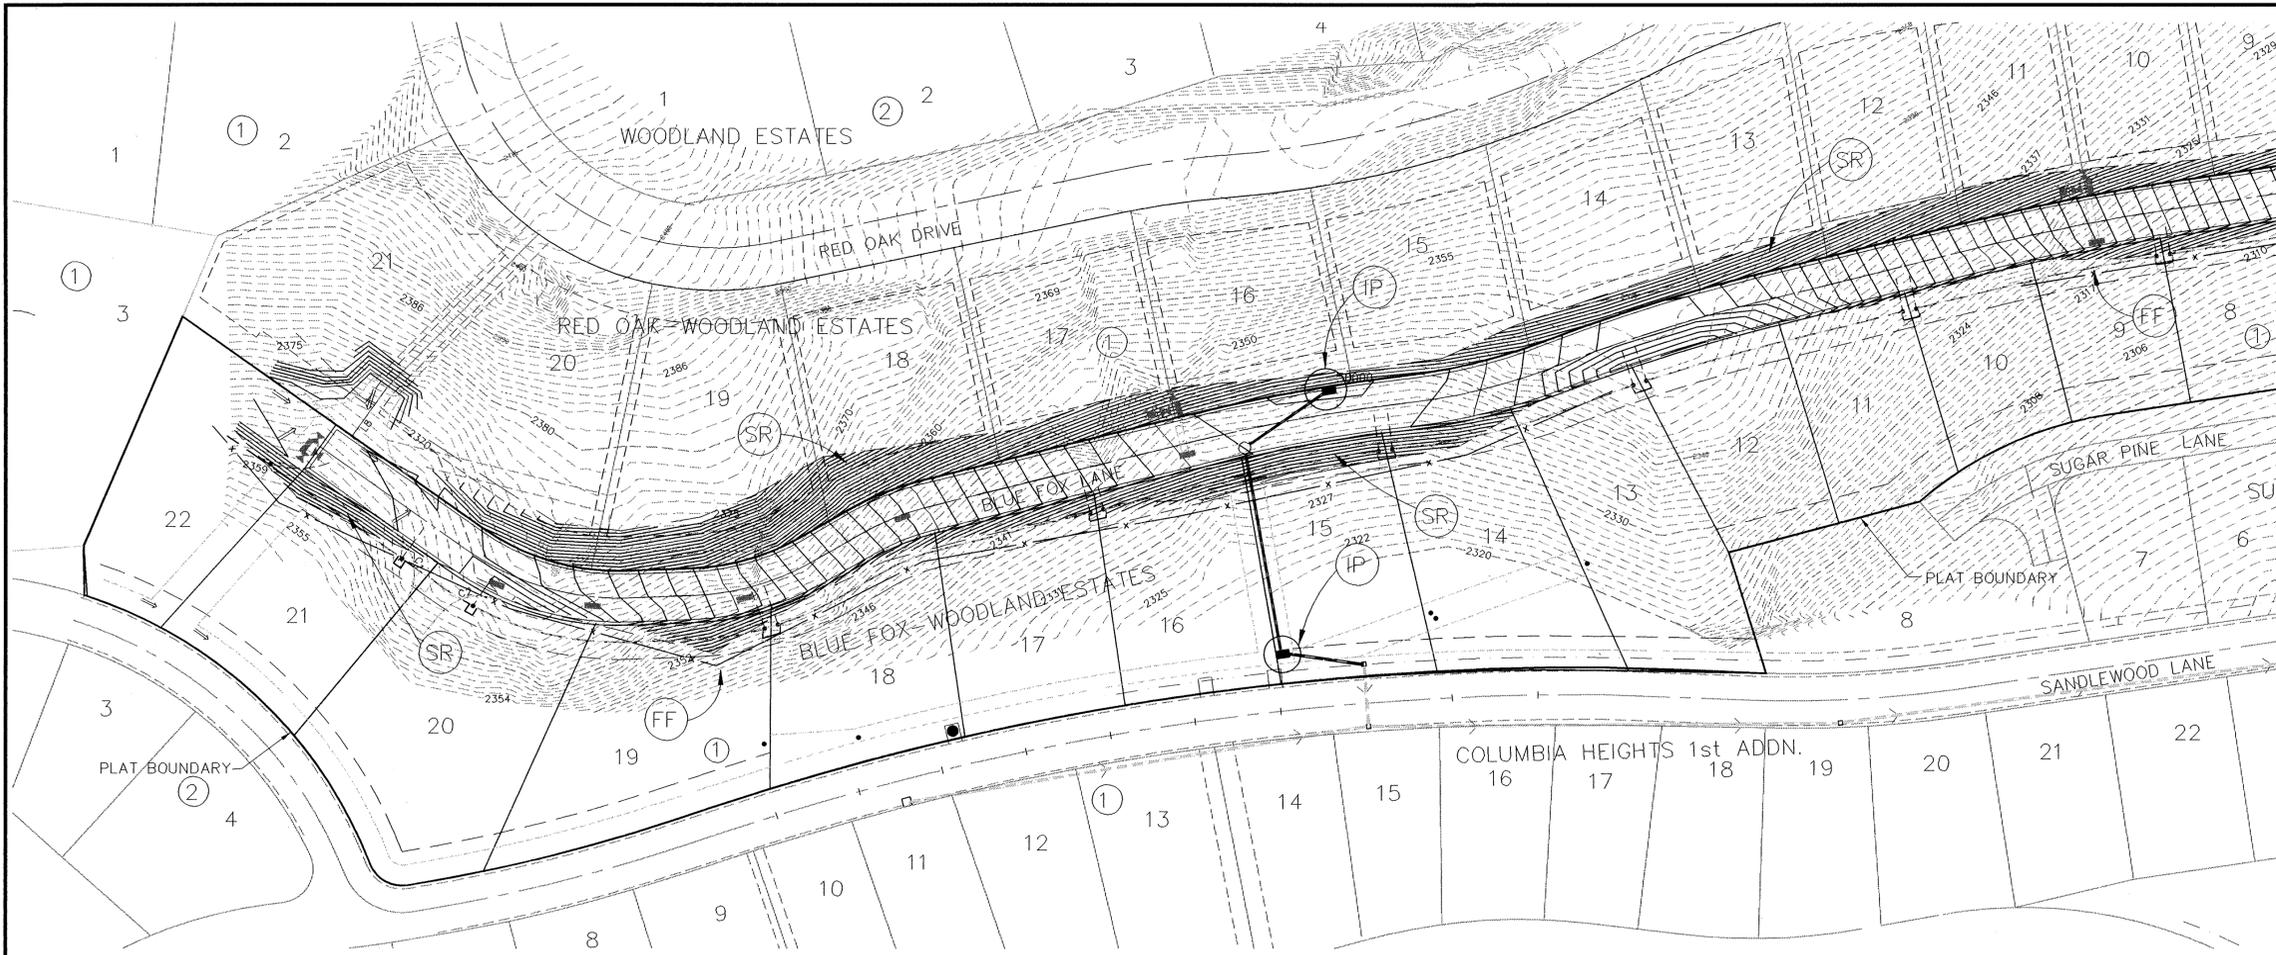


UNDERGROUND SERVICE ALERT  
 ONE-CALL NUMBER  
 456-8000  
 CALL TWO BUSINESS DAYS  
 BEFORE YOU DIG

**CLC**  
 Associates, Inc.  
 Planning  
 Engineering  
 Architecture  
 Landscape Architecture  
 Land Surveying  
 707 W. 7th Avenue, Suite 200  
 Spokane, WA 99204  
 Phone: (509) 456-8000  
 Fax: (509) 456-8004

# RECORD DRAWING

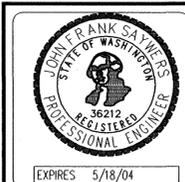

PREPARED UNDER THE DIRECT SUPERVISION OF JOHN F. SAYERS, P.E. WASHINGTON REGISTRATION NO. 36212 FOR AND ON BEHALF OF CLC ASSOCIATES, INC.


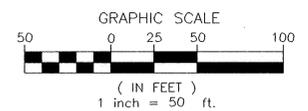


Date	Description
02/27/01	PRELIMINARY SUBMITTAL
05/10/02	FIRST SUBMITTAL
03/12/03	THIRD SUBMITTAL
05/28/03	FINAL SUBMITTAL
<b>8-26-04 RECORD DRAWING</b> by STI Northwest, Inc.	

Project Number: S000588  
 CLC Job Number: S000588  
 Drawn By: EMT,SMM  
 Designed By: EMT  
 Checked By: JFS

THESE PLANS ARE INSTRUMENTS OF PROFESSIONAL SERVICE AND ARE PROTECTED BY COMMON LAW, STATUTE AND UNDER RESERVED RIGHTS INCLUDING COPYRIGHT. THEY MAY NOT BE REPRODUCED OR USED FOR ANY PURPOSE WITHOUT THE WRITTEN CONSENT OF CLC ASSOCIATES, INC. (AN AFFILIATE OF COLORADO LAND CONSULTANTS, INC.)

I have reviewed the construction and to my knowledge find it to be in substantial conformance with the approved certified plans and Standard Specifications except as noted.

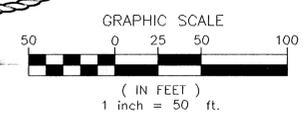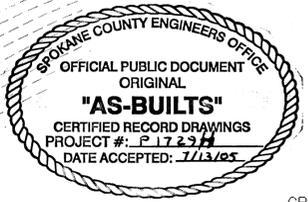

COUNTY DATUM  
 TBM ON 604 SPIKE AT STA. 24+00  
 50' RT. ON NORTHWOOD DRIVE  
 ELEVATION=2417.11 (NAVD-27)

DEVELOPER'S APPROVAL \_\_\_\_\_ DATE \_\_\_\_\_


EROSION AND SEDIMENT CONTROL  
 BLUE FOX - WOODLAND ESTATES PUD  
 PLAN AND DETAILS  
 STA. 11+00 TO VISTA PARK DRIVE  
 SPOKANE COUNTY, WASHINGTON

10 OF 10  
 Street Title  
 EROSION AND SEDIMENT CONTROL  
 Street Number

P-1729M Eng. As-Built

# TOPOGRAPHIC SURVEY BLUE FOX POND

SPOKANE COUNTY, WASHINGTON

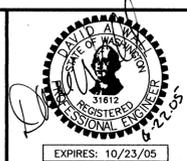

THOMAS, DEAN & HOSKINS, INC.  
ENGINEERING CONSULTANTS  
GREAT FALLS - BOZEMAN - KALISPELL - HELENA  
SPOKANE - LEWISTON  
MONTANA  
WASHINGTON  
IDAHO

**TD & H**

REVISIONS  
BY DATE DESCR BY DATE DESCR BY DATE DESCR

DRAWN BY: EJD  
DESIGNED BY: DAW  
QUALITY CHECK: DAW  
DATE: 6/22/05  
JOB NO. S05-005  
FIELDBOOK SDR


BLUE FOX POND SURVEY  
SPOKANE COUNTY, WASHINGTON

TOPOGRAPHIC SURVEY

CAD NO. S05-005-BM.DWG  
SHEET 1 OF 2

### LEGEND

	EXISTING EDGE OF GRAVEL
	EXISTING RETAINING WALL
	EXISTING PROPERTY LINE
	EXISTING CHAIN LINK FENCE
	EXISTING POND BOTTOM
	EXISTING 5' CONTOUR LINE
	EXISTING 1' CONTOUR LINE
	EXISTING PAINT STRIPE
	CONTROL POINT
	EXISTING IRON PIPE
	EXISTING CATCH BASIN
	EXISTING DRYWELL
	EXISTING VAULT WITH PIPE
	EXISTING PIPE
	EXISTING SANITARY SEWER MANHOLE

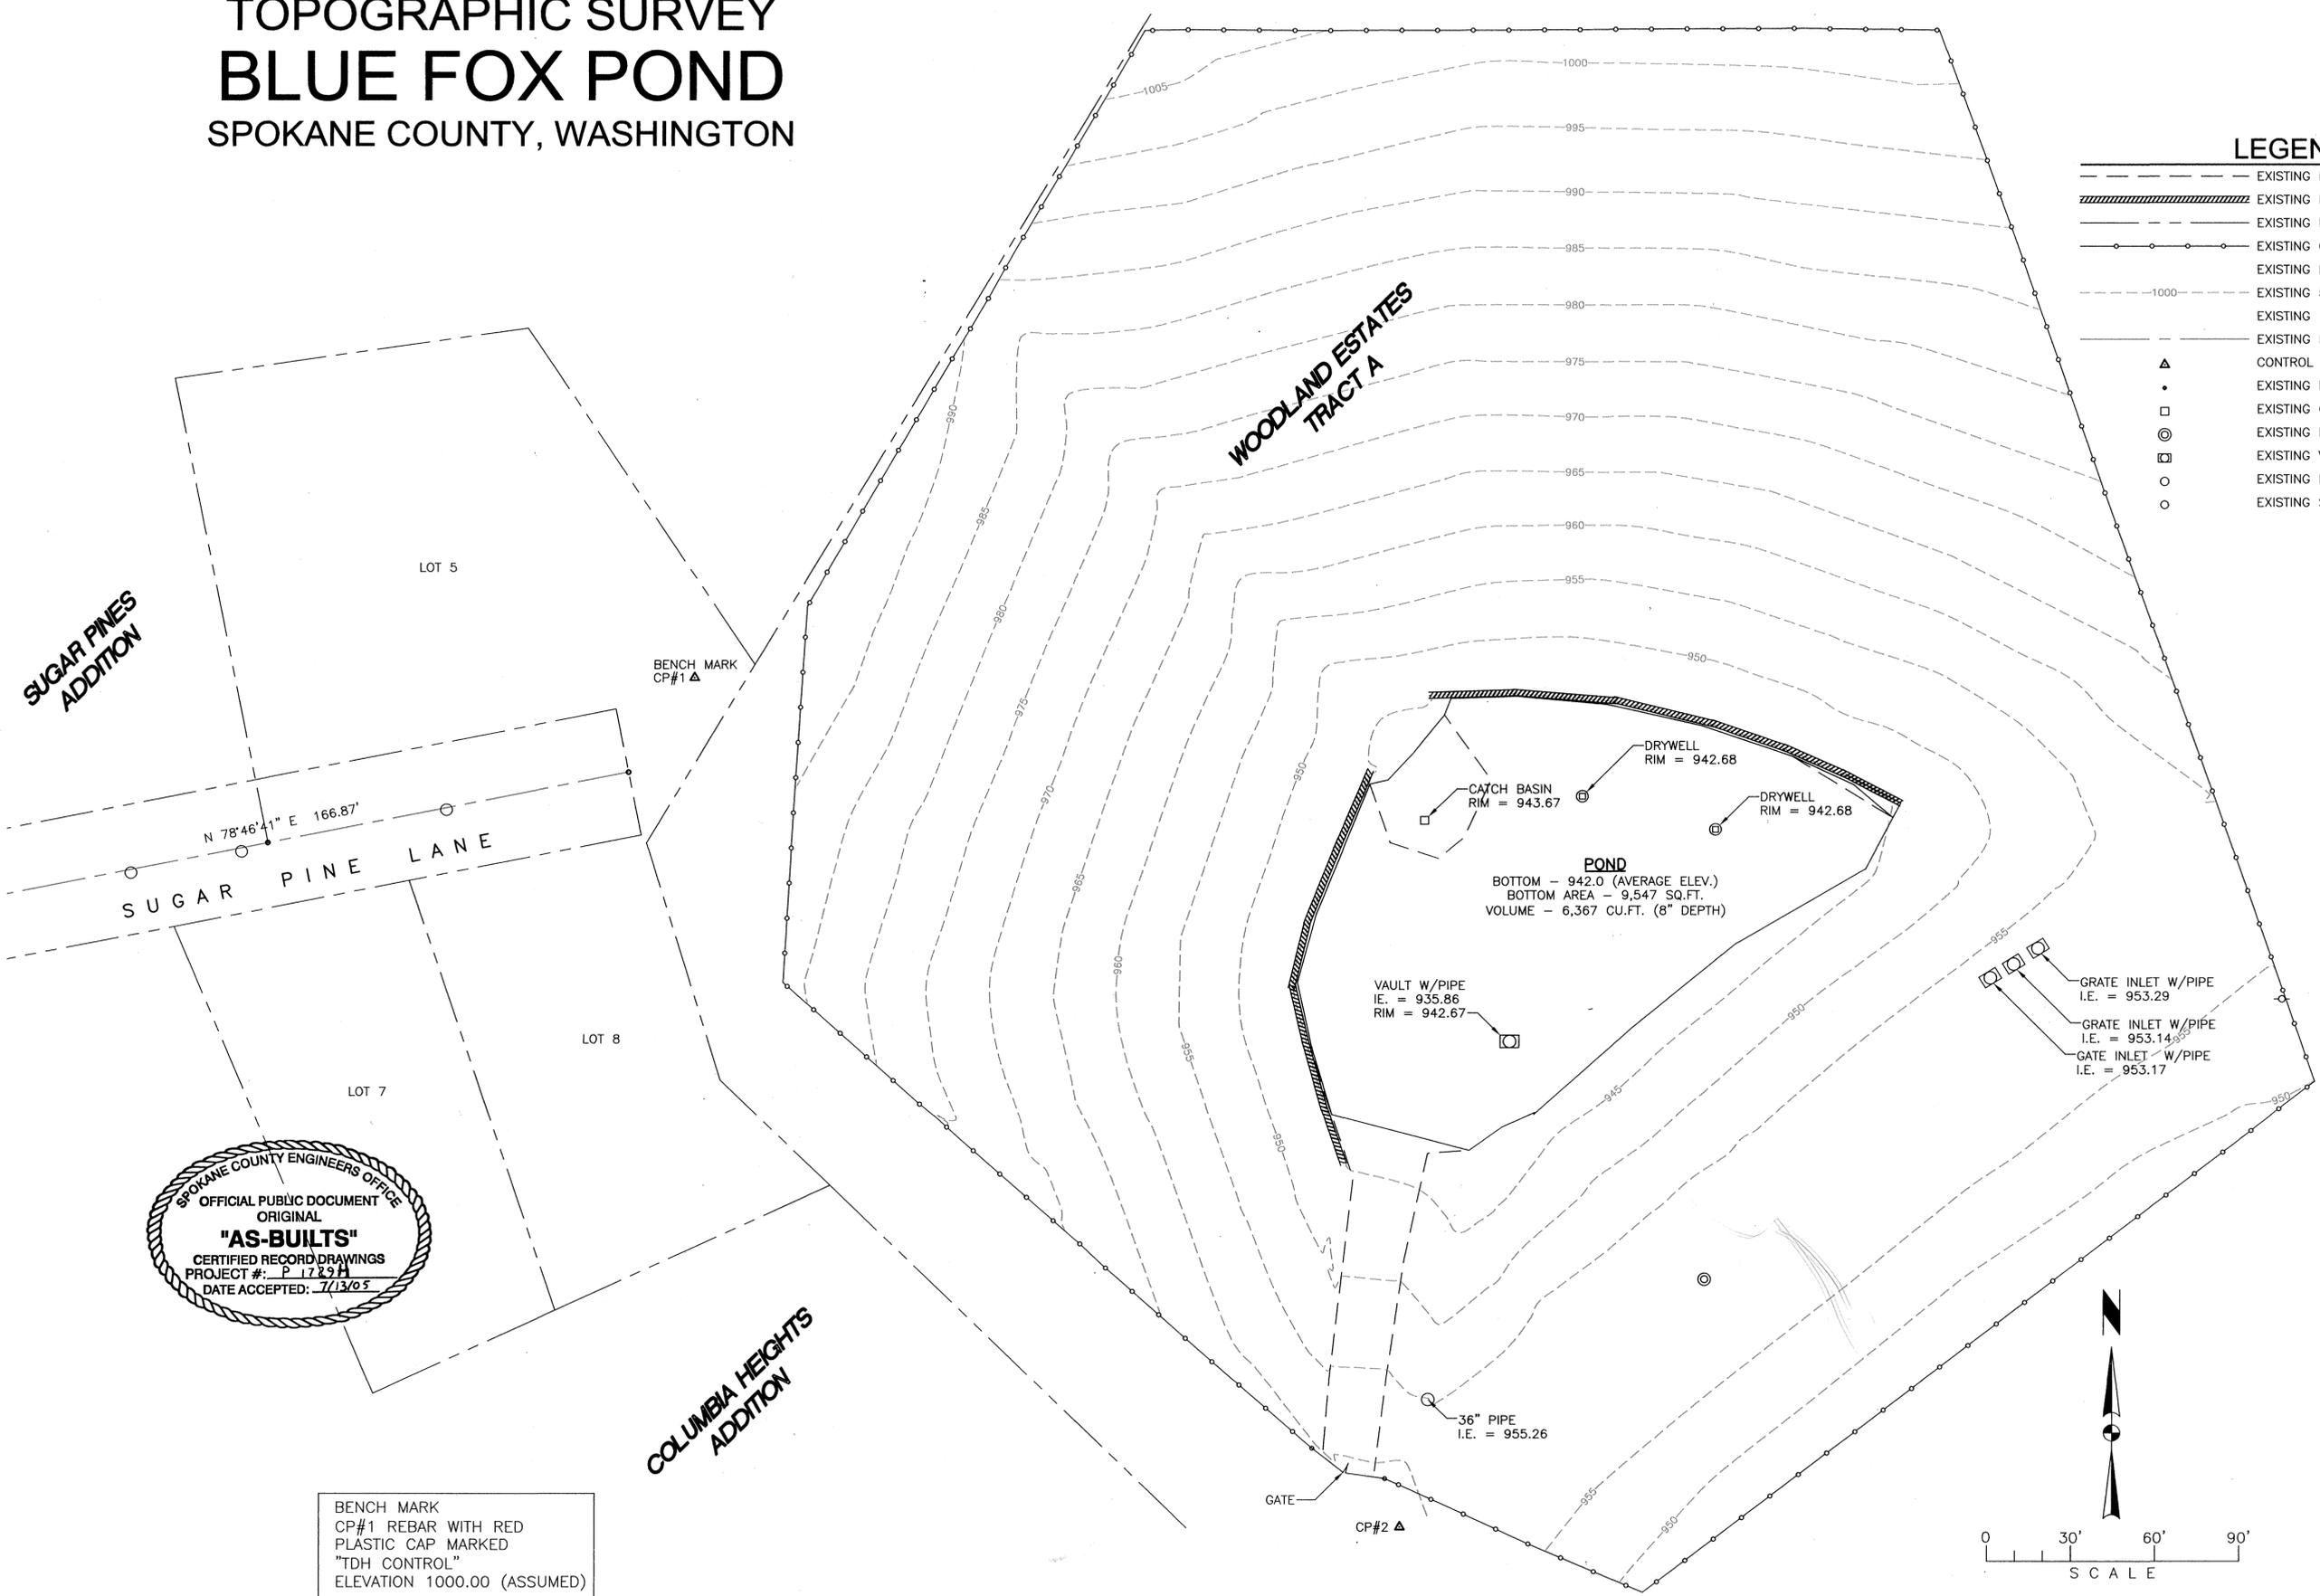

SPOKANE COUNTY ENGINEERS OFFICE  
OFFICIAL PUBLIC DOCUMENT  
ORIGINAL  
"AS-BUILTS"  
CERTIFIED RECORD DRAWINGS  
PROJECT #: P 1729H  
DATE ACCEPTED: 7/13/05

BENCH MARK  
CP#1 REBAR WITH RED  
PLASTIC CAP MARKED  
"TDH CONTROL"  
ELEVATION 1000.00 (ASSUMED)

p-1729H Eng & Built

