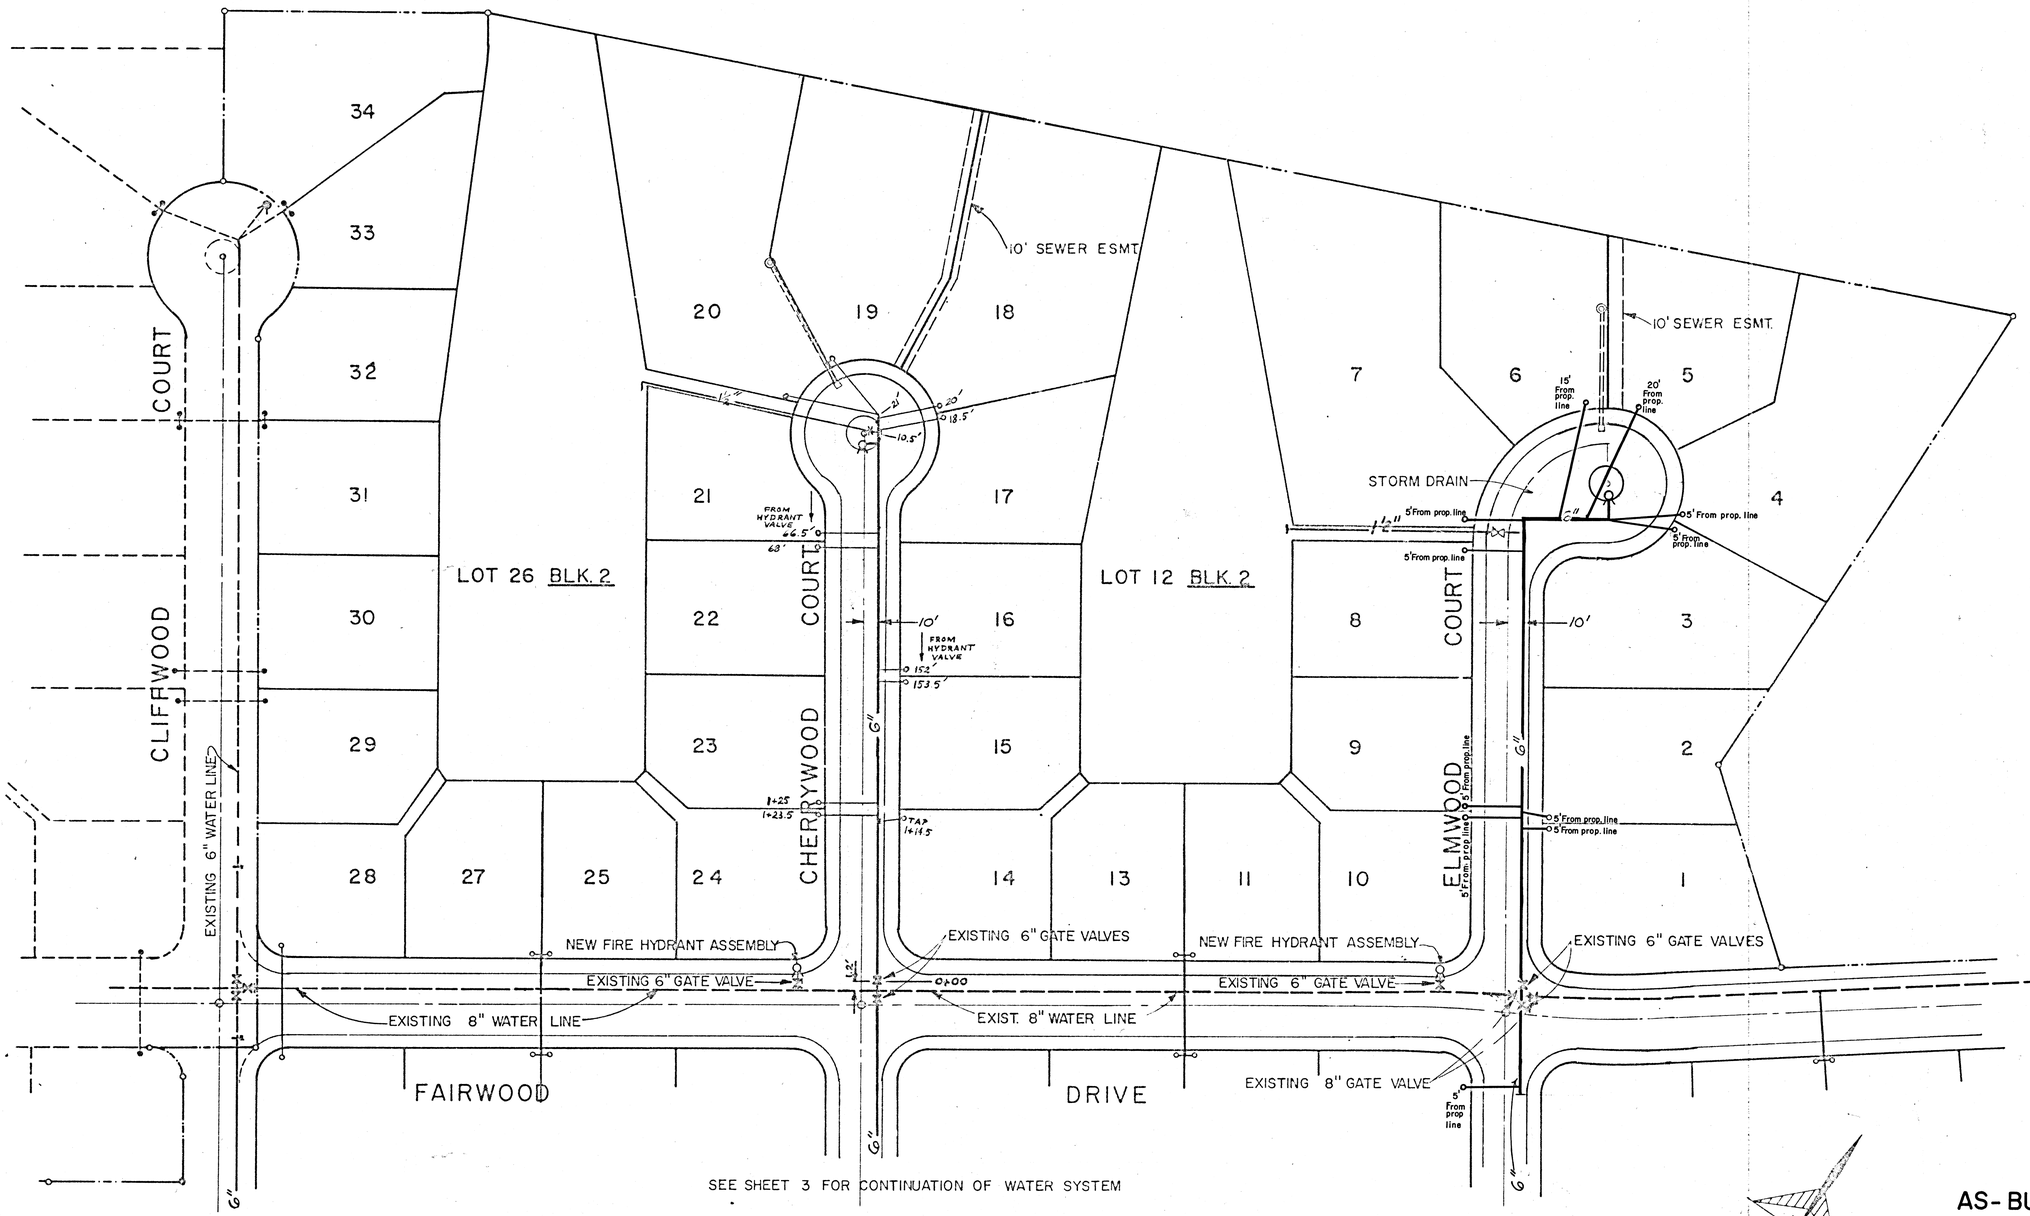

AS-BUILT
JUNE 1976

RALPH E. FLAGAN
STATE OF WASHINGTON
7580
REGISTERED
PROFESSIONAL LAND SURVEYOR

DATE	NO	REVISION	BY
DRAWN		RLM	
CHECKED		SCALE AS SHOWN	
APPROVED		DATE ,1969	
		JOB NO 205-C	

FAIRWOOD PARK # 2 - PHASE #2 - WAIKIKI SYNDICATE

WATER DISTRIBUTION SYSTEM

PLAN VIEW OF WATER DISTRIBUTION SYSTEM

ESVELT & SAXTON
ENGINEERS
CONSULTING
321 SYMONS BLDG SPOKANE, WASHINGTON

SHEET NO. 2
OF 9

SEE SHEET 2 FOR CONTINUATION OF WATER SYSTEM

EXISTING 6" WATER LINE

FAIRWOOD DRIVE

NEW FIRE HYDRANT ASSEMBLY

EXISTING 6" GATE VALVE

EXISTING 8" WATER LINE

MEET EXISTING WATER LINE
0+20

EXISTING 6" GATE VALVES

0+00

EXISTING 8" GATE VALVES

SHEET 4 FOR CONTINUATION OF WATER SYSTEM

22 23 24 41 40 38 37 28 27 25 24 15 14

CLIFFWOOD COURT

CHERRYWOOD COURT

ELMWOOD COURT

10' DRN. & UTIL. ACCESS ESMT.

1 1/2" LINE

STORM DRAIN

1+39
1+40.5
1+36
1+37.5

1 1/2" SERVICE

LOT 50 BLK. 1

LOT 39 BLK. 1

LOT 26 BLK. 1

LOT 13 BLK. 1

49 48 47 46 42 43 44 45 36 35 34 33 29 30 31 32 23 22 21 20 16 17 18 19

10' From prop.line
7' From prop.line
5' From prop.line
21.6 From Prop. Line
5'
5.5'

21.5'
20'
18.5'
17'
12.5'
F.H. VALVE
MEASUREMENTS FROM F.H. VALVE
14'
15.5'

14 13 12 11 10 9 8 7 6 5 4 3 2

BLOCK 3 FAIRWOOD PARK 1

0 10 25 50 100
SCALE

AS-BUILT
CLIFFWOOD & CHERRYWOOD
JUNE 1976

RALPH E. FLAGAN
STATE OF WASHINGTON
REGISTERED
PROFESSIONAL LAND SURVEYOR
7580

DATE	NO.	REVISION	BY
DRAWN		R.L.M.	SCALE AS SHOWN
CHECKED			DATE 1969
APPROVED			JOB NO. 205-C

FAIRWOOD PARK # 2 - PHASE # 2 - WAIKIKI SYNDICATE

WATER DISTRIBUTION SYSTEM

PLAN VIEW OF WATER DISTRIBUTION SYSTEM

SHEET NO. 3 OF 9

ESVELT & SAXTON
CONSULTING ENGINEERS
321 SYMONS BLDG.
SPOKANE, WASHINGTON