





COVER SHEET FOR WELLINGTON HEIGHTS 3RD ADDITION STREET AND STORM DRAINAGE PLANS

SPokane County, Washington



DATE OF DAY: _____








CONTRACT NO. _____

DATE OF DAY: _____


SECTION 36 T27 N. R43 E. W4.
 SPOKANE COUNTY, WASHINGTON

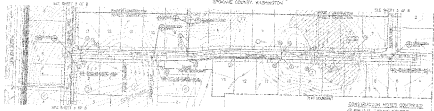

AS SHOWN ON PLAN










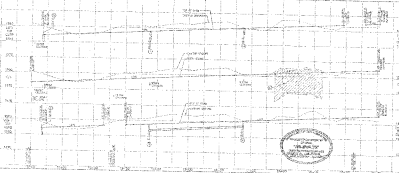











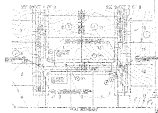

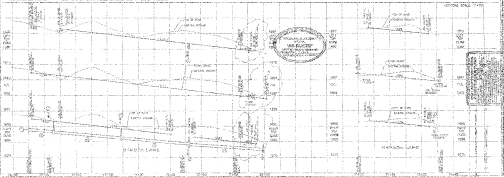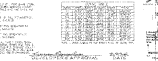


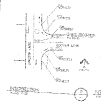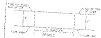

SCALE OF DRAWING

NOTES

1. ALL WORK TO BE DONE IN ACCORDANCE WITH THE SPECIFICATIONS AND CONDITIONS OF CONTRACT.
2. THE CONTRACTOR SHALL BE RESPONSIBLE FOR OBTAINING ALL NECESSARY PERMITS AND APPROVALS.
3. THE CONTRACTOR SHALL MAINTAIN ACCESS TO ALL ADJACENT PROPERTIES AT ALL TIMES.
4. THE CONTRACTOR SHALL PROTECT ALL EXISTING UTILITIES AND STRUCTURES.

WALLINGTON HEIGHTS
3RD EDITION


























WELLINGTON HEIGHTS
 BRD ADDITION

