AS-BUILT CONSTRUCTION PLANS FOR

WEST MEADOWS - 1ST ADDITION

NE 1/4 OF SECTION 4, TOWNSHIP 24 NORTH RANGE 42 EAST W.M.,
SPOKANE COUNTY, WASHINGTON

GENERAL NOTES

1. ALL WORK AND MATERIALS SHALL BE IN CONFORMANCE WITH THE "SPOKANE COUNTY STANDARDS FOR ROAD AND SEWER CONSTRUCTION" (GRAY AND BLUE BOOK) AS AMENDED.
2. PRIOR TO SITE CONSTRUCTION, THE CONTRACTOR IS RESPONSIBLE FOR LOCATING ALL UNDERGROUND UTILITIES. CALL UTILITIES UNDERGROUND UTILITY LOCATION SERVICE AT 1-800-424-5555 BEFORE YOU DIG.
3. LOCATIONS OF EXISTING UTILITIES SHOWN IN THE PLANS ARE APPROXIMATE. THE CONTRACTOR SHALL BE RESPONSIBLE FOR LOCATING ALL UNDERGROUND UTILITIES. ANY CONFLICTING UTILITIES SHALL BE RELOCATED PRIOR TO CONSTRUCTION OF PARKING AREAS AND DRAINAGE FACILITIES.
4. ITS, OR CONTRACTOR IS REQUIRED TO HAVE A COMPLETE SET OF THE ACCEPTED CONSTRUCTION DRAWING PLANS ON SITE AT ALL TIMES FOR CONSTRUCTION OR INSPECTION.
5. IF THE CONTRACTOR DISCOVERS ANY DISCREPANCIES BETWEEN THE PLANS AND EXISTING CONDITIONS ENCOUNTERED, THE CONTRACTOR SHALL IMMEDIATELY NOTIFY THE DESIGN ENGINEER.
6. THE CONTRACTOR SHALL TAKE PRECAUTIONS TO PROTECT THE INFILTRATION CAPACITY OF STORM WATER FACILITIES (E.G. LIMIT THE FACILITY WITH HEAVY EARTH-MOVING EQUIPMENT, SHOW COMPLETION OF THE INFRASTRUCTURE, ETC.)
7. DURING CONSTRUCTION, THE CONTRACTOR/DEVELOPER SHALL BE RESPONSIBLE FOR PROVIDING CONTINUOUS DUST CONTROL THROUGH THE USE OF WATER TRUCKS, SPRINKLING OR OTHER APPROVED METHODS.
8. UNDERGROUND STRUCTURES TO BE 30" ROUND PVC FLOW DRAIN BOX OR APPROVED EQUAL.
9. CONTRACTOR SHALL STRICTLY ADHERE ABOVE AND BELOW GROUNDWATER TECH MEMO AS NECESSARY TO ESTABLISH AND MAINTAIN VEGETATION.
10. CURB RAMPS SHALL BE CONSTRUCTED PER SPOKANE COUNTY PUBLIC WORKS STANDARD PLAN A-5.
11. REFLECTIVE RETAINER SHALL BE CONSTRUCTED PER SPOKANE COUNTY PUBLIC WORKS STANDARD PLAN A-7.
12. ALL TRIANGULAR APPROACH ISLES SHALL BE CONSTRUCTED PER SPOKANE COUNTY ENGINEERS STANDARD PLAN A-4 AT THE TIME OF RESIDENTIAL HOME CONSTRUCTION.
13. A CURB DROP PER SPOKANE COUNTY STANDARD PLAN #A-7 WITH AN 11" DEPRESSION OF 2' WILL BE CONSTRUCTED ON EACH SIDE OF ALL DRIVEWAY APPROACHES AT TIME OF CONSTRUCTION.
14. ROAD GRADES WILL ALLOW STORM FLOWS TO POND A CERTAIN DEPTH OF 1'-11" BELOW ADJACENT CURB FLOW LINE, SHOULD GRADE EXCEED THIS, POND A CERTAIN DEPTH OF 3' BELOW ADJACENT CURB FLOW LINE, UNLESS OTHERWISE NOTED.

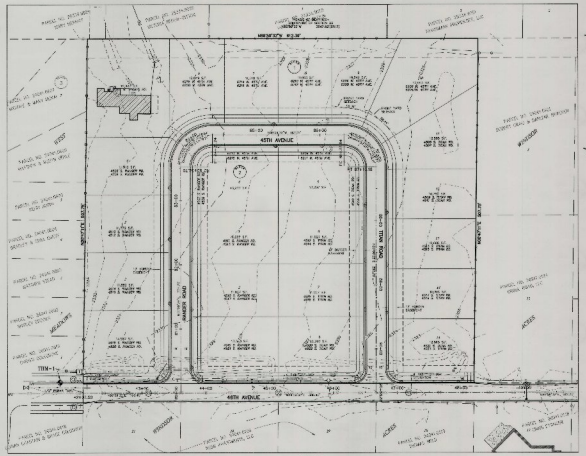

SITE MAP
SCALE: 1"=200'

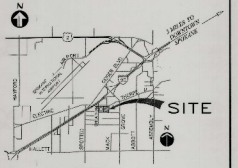

VICINITY MAP
NOT TO SCALE

LEGEND

- INT = INTERSECTION
- CR = CURB RETURN
- TC = TOP OF CURB
- FL = FLOW LINE
- TR = TOP OF ROAD
- BCC = BEGINNING OF CONSTRUCTION
- ECC = END OF CONSTRUCTION
- = UTILITY POLE
- = UTILITY BOX
- = HANDICAP STREET SIGN
- = GAS VENT
- = TRANSFORMER
- = NEW SEWER MANHOLE
- = EXISTING SEWER MANHOLE
- = STORM MANHOLE
- = POST-CON STORM BOX
- = SANITARY SEWER SERVICE
- = SANITARY SEWER
- = WATER SERVICE
- = WATER LINE
- = STORM DRAIN
- = BUTTERFLY FLEXTEE
- SP = SUMPTOP PUMP
- = TYPE I CURB INLET
- = TYPE II CURB INLET
- = ASPHALT
- = CONCRETE
- = TEMPORARY BENCHMARK

DRAWING INDEX

COVER SHEET	1
45TH AVENUE PLAN & PROFILE	2
CRAWFORD LANE PLAN & PROFILE	3
ROAD INTERSECTION DETAILS	4
DETAILS	5
TESC PLAN, NOTES & DETAILS	6

TEMPORARY BENCH MARK (TBM)

TBM-1 NAVD 88
SET NAIL IN LEAD WITH 1-1/2" ALUMINUM WASHER "HLC INC CONTROL"
ELEV = 2224.67

RECORD DRAWING 09/12/19

This drawing represents the construction work as-built as can be determined. This as-built was created from observations and data collected by the following: Contractor, Surveyor, Engineer, Inspector, and others. The drawing is thought to be accurate based upon available information. It should be used only as a general representation of the constructed work. It has not been revised for correlation and by any knowledge the As-Built Drawings conform to the Contract Plans and the plans and Standard specifications except as noted.

4/24/19

OFFICIAL PUBLIC DOCUMENT
ORIGINAL
"AS-BUILTS"
CERTIFIED RECORD DRAWINGS
PROJECT # 2242
DATE ACCEPTED 5/1/19

SHEET 1 OF 6

CALL BEFORE YOU DIG 811

Ackerlund & Clark, Inc.
Civil Engineering
Spokane, WA 99201-1262
(509) 467-4828 FAX 467-8151
www.ackerlund.com
Project No. 2017-042.000

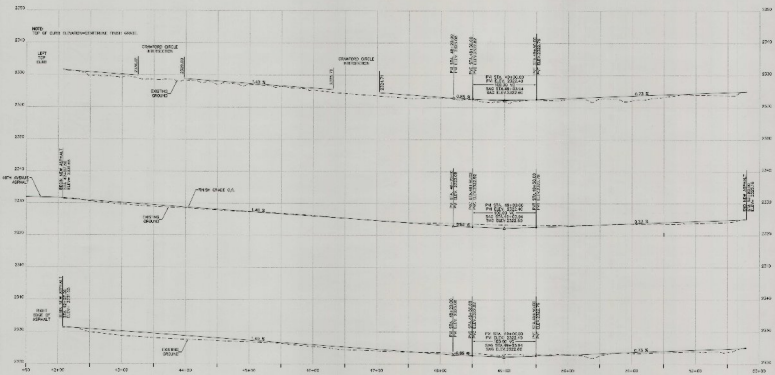

46TH AVENUE PROFILE STA 42+07.50 TO 52+80.00
SCALE: 1"=50' HORIZ.
1"=20' VERT.

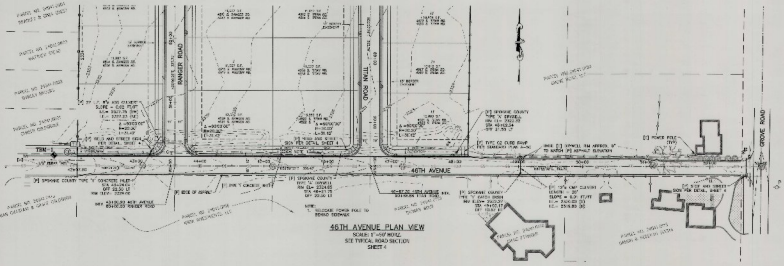

46TH AVENUE PLAN VIEW
SCALE: 1"=50' HORIZ.
SEE TYPICAL ROAD SECTION SHEET 4

NOTES:
1. SLOPE CURB INLET & LOW POINT EAST TO DISCONNECT TO CLEAR FIRE HYDRANT

CURB DROP LOCATIONS		
STA	SIDE	ROAD
42+27	LEFT	46TH AVENUE
43+21	LEFT	46TH AVENUE
44+27	LEFT	46TH AVENUE
45+27	LEFT	46TH AVENUE
46+27	LEFT	46TH AVENUE
47+07	LEFT	46TH AVENUE
47+97	LEFT	46TH AVENUE

LEGEND

(E)	= EXISTING
(P)	= PROPOSED
INTX	= INTERSECTION
GR	= CURB REVEAL
TC	= TOP OF CURB
FL	= FLOW LINE
BR	= BACK OF ROAD
BOC	= BEGINNING OF CONSTRUCTION
EOC	= END OF CONSTRUCTION
	= UTILITY POLE
	= UTILITY BOX
	= PROPOSED STREET SIGN
	= GUY WIRE
	= TRANSFORMER
	= NEW SEWER MANHOLE
	= EXISTING SEWER MANHOLE
	= CATCH BASIN
	= SANITARY SEWER SERVICE
	= SANITARY SEWER
	= WATER SERVICE
	= WATER LINE
	= STORM DRAIN
	= DUMPSTER PLATFORM
DP	= DUMPSTER PAD
	= TYPE I CURB INLET
	= TYPE II CURB INLET
	= ASPHALT
	= GRAVEL

OFFICIAL PUBLIC DOCUMENT
ORIGINAL
"AS-BUILTS"
CERTIFIED RECORD DRAWINGS
DATE ACCEPTED: 9/12/19

RECORD DRAWING 09/12/19

This drawing represents the construction work as near as could be determined from the information and observations and was collected in the field during construction by the contractor, surveyor, inspector and others. 

9/12/19

SHEET 3 OF 6

CALL BEFORE YOU DIG 811

BENCH MARK DATUM	SCALE	DATE	STAFF
BM: ELEVATION	HORIZONTAL 50'	9/12/19 DRAWN	RWS
ELEVATION: 5,000.00'	VERTICAL 1/4"	9/12/19 CHECKED	DP
DATUM: NAVD 88		APPROVED	

ADAMS & CLARK, Inc.

46TH AVENUE
STA 42+07.50 TO 52+80.00
PLAN AND PROFILE
WEST MEADOWS - 1ST ADDITION

TYPE OF IMPROVEMENT: STREET
PUBLIC WORKS | PUBLIC LANDS
2017-01-006

No.	REVISIONS	DATE	INIT.	FROM: AS BUILT	TO: ASBUILT

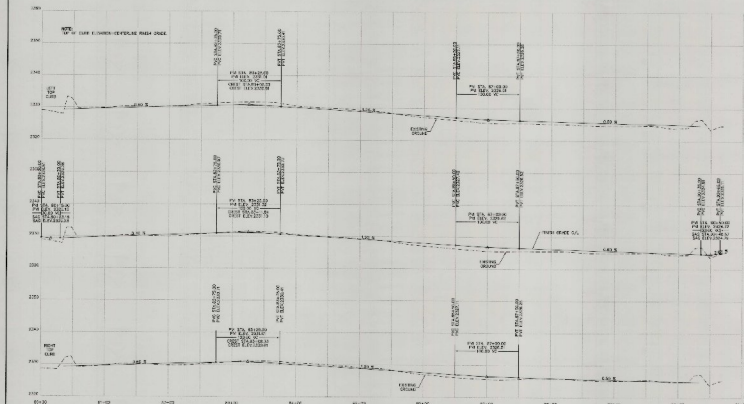

RANGER ROAD/46TH AVENUE/TITAN ROAD PROFILE STA 80+00 TO 90+68.88
SCALE: 1"=50' HORZ.
1"=10' VERT.

CURB DROP LOCATIONS		
STA	SIDE	ROAD
80+19	LEFT	CRAWFORD
80+19	RIGHT	CRAWFORD
81+40	LEFT	CRAWFORD
81+30	RIGHT	CRAWFORD
82+05	RIGHT	CRAWFORD
82+40	LEFT	CRAWFORD
82+05	RIGHT	CRAWFORD
83+26	RIGHT	CRAWFORD
84+10	LEFT	CRAWFORD
84+41	RIGHT	CRAWFORD
85+78	LEFT	CRAWFORD
85+30	RIGHT	CRAWFORD
85+98	LEFT	CRAWFORD
86+03	RIGHT	CRAWFORD
87+17	LEFT	CRAWFORD
87+78	RIGHT	CRAWFORD
87+87	LEFT	CRAWFORD
88+02	RIGHT	CRAWFORD
88+98	LEFT	CRAWFORD
89+36	RIGHT	CRAWFORD
89+43	LEFT	CRAWFORD
89+78	RIGHT	CRAWFORD
90+25	LEFT	CRAWFORD

LEGEND

- BC = BEGIN C
- EC = END C
- PVI = PI
- CR = CURB RETURN
- TC = TOP OF CURB
- FL = FLOW LINE
- EP = EDGE OF ROAD
- BCC = BEGIN OF CONSTRUCTION
- ECC = END OF CONSTRUCTION
- = UTILITY POLE
- = UTILITY BOX
- = PROPOSED STREET SIGN
- = GUY WIRE
- = TRANSFORMER
- = NEW SEWER MANHOLE
- = EXISTING SEWER MANHOLE
- = STORM DRAIN
- = SANITARY SEWER SERVICE
- SS = SANITARY SEWER
- = WATER MAINS
- W = WATER LINE
- ST = STORM SEWER
- OH = OVERHEAD ELECTRIC
- OP = OVERFLOW PIPE
- = TYPE I CURB INLET
- = TYPE I CURB INLET
- = ASPHALT
- = GRAVEL

OFFICIAL PUBLIC DOCUMENT
ORIGINAL
"AS-BUILTS"
CERTIFIED RECORD DRAWINGS
SUBMITTED BY: J. SALES
DATE ACCEPTED: 09/12/19

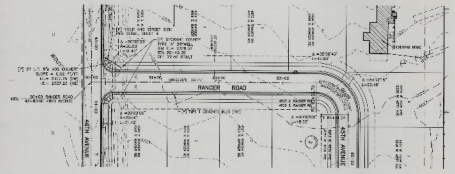

RANGER ROAD/45TH AVENUE STA 80+00 TO 85+00
SCALE: 1"=50' HORZ.

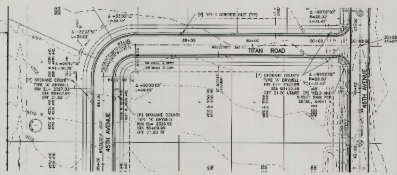

45TH AVENUE/TITAN ROAD STA 85+00 TO 90+68.88
SCALE: 1"=50' HORZ.

RECORD DRAWING 09/12/19

This drawing represents the constructed work as best as can be determined. This set has been marked from information provided by the contractor and/or subcontractors or the contractors' surveyor, inspector or others. This drawing is thought to be accurate based upon available information. It should be used only as a general representation of the constructed work. There may be variations that do not affect the intent but it is not to be used with confidence with a ground survey and plans are standard specification's owner's option.

9/12/19

SHEET 3 OF 6

CALL BEFORE YOU DIG 811

NO.	REVISIONS	DATE	PROJ. ENGR.	AS BUILT	TO ACCEPT

BENCH MARK DATUM	SCALE	DATE	STAFF
DESCRIPTION	HORIZONTAL 1"	R.W.P.	PMS
ELEVATION 2222.57	VERTICAL 10'	R.W.P.	DESIGN DH
LOCATION SEE #			APPROVED

ADAMS & CLARK, Inc.
www.adamsandclark.com
2120 W. Routt Ave.
Spokane, Wa 99201
(509) 747-4800 FAX(509) 747-0503

RANGER ROAD/TITAN ROAD
STA 80+00.00 TO 90+68.88
PLAN AND PROFILE
WEST MEADOWS 1ST ADDITION

TYPE OF IMPROVEMENT STREET

PROJECT NUMBER	PLAN NUMBER
2017-01-084	

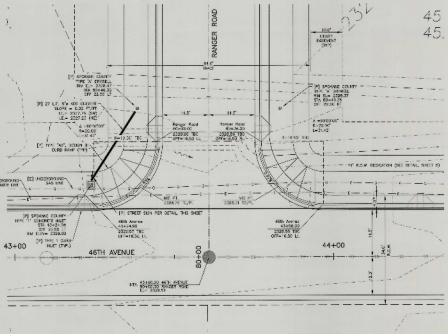

46TH AVENUE / CRAWFORD LANE - WEST INTERSECTION
SCALE: 1"=10'

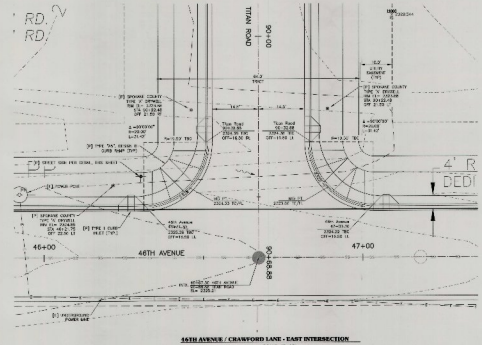

46TH AVENUE / CRAWFORD LANE - EAST INTERSECTION
SCALE: 1"=10'

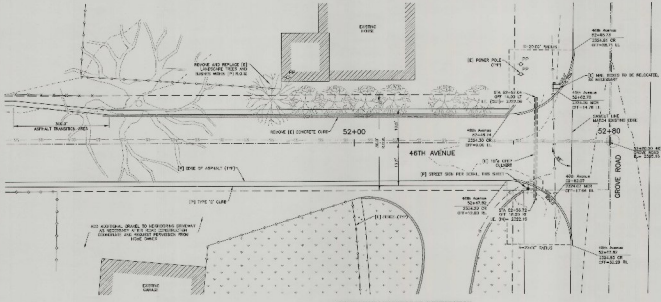

46TH AVENUE / GROVE ROAD INTERSECTION
SCALE: 1"=10'

OFFICIAL PUBLIC DOCUMENT
ORIGINAL
"AS-BUILTS"
CERTIFIED RECORD DRAWINGS
DATE ADOPTED: 9/12/19

RECORD DRAWING 09/12/19

This drawing represents the construction work as-built as can be determined. This as-built was prepared from observations and data collected in the field during construction by the contractor, engineer, surveyor and others. The contractor is responsible for the accuracy and completeness of this as-built record. Contractor signature is representative of the contractors work. I have reviewed the construction and to my knowledge that it is true & correct and represents with approved certified plans and Standard specifications except as noted.

4/8/19

LEGEND

[E]	= EXISTING
[P]	= PROPOSED
INT=	= INTERSECTION
TB	= TOP OF BANK
TC	= TOP OF CURB
FL	= FLOW LINE
FW	= FACE OF WALL
BOC	= BEGINNING OF CONSTRUCTION
EOC	= END OF CONSTRUCTION
-o-	= UTILITY POLE
-s-	= UTILITY SIGN
-s-	= PROPOSED STREET SIGN
-o-	= GUY WIRE
-t-	= TRANSFORMER
-s-	= SIGN SCROLL WAY-VALVE
-o-	= EXISTING SEWER MANHOLE
-o-	= CATCH BASIN
-o-	= PROPOSED DRAIN INLET
-s-	= SANITARY SEWER SERVICE
SS	= SANITARY SEWER
W	= WATER SERVICE
W	= WATER LINE
SD	= STORM DRAIN
OHP	= OVERHEAD ELECTRIC
GP	= GARBAGE PICKUP
TYP	= TYPE - CURB INLET
TYP	= TYPE - CURB INLET
	= STORM DRAIN SWALE
	= ASPHALT
	= GRAVEL

SHEET 4 OF 6

CALL BEFORE YOU DIG 811

BY	REVISIONS	DATE	PROJ	TYPE	AS BUILT	"S" MONTH

BENCH MARK DATUM	SCALE	DATE	STAFF
DESIGNED SJC	HORIZONTAL 10'	6/18/19 DESIGN	RSS
DRAWN SMS SJC	VERTICAL NC	6/18/19 DRAWN	DV
LOCATION TABLE 81		APPROVED	

ADAMS & CLARK, Inc.
www.adamsclark.com
1120 N. Liberty Ave.
Spokane, WA 99201
(509) 747-4868 FAX 747-8913

DETAILS
INTERSECTION DETAILS
WEST MEADOWS 1ST ADDITION

TYPE OF IMPROVEMENT	SUBDIV
PROJECT MANAGER	"S.M. NUMBER
2017-01-066	

GENERAL SWALE CONSTRUCTION NOTES

1. THE INFILTRATION BASINS (SWALES) LOCATION OR BASE PLANS ARE AN INTEGRAL PART OF THE STORMWATER DRAINAGE ANALYSIS AND DESIGN PROVIDED FOR THIS SITE. THE CONTRACTOR SHALL TAKE GREAT CARE IN ACCURATELY ESTABLISHING THE GRADE BOTTOM ARENAS AND ELEVATIONS AS INDICATED.
2. IT IS IMPERATIVE FOR THE PROPER FUNCTION OF THE INFILTRATION BASINS THAT THE BOTTOMS AND SUBGRADE BELOW THE SWALES BE AS UNCOMPACTED AS POSSIBLE (TO A MINIMUM DEPTH OF 18" BELOW). NO EQUIPMENT SHOULD BE DRIVEN OVER SWALES.
3. THE DESIGNED SWALE AREAS ARE TO BE STAKED AS EARLY AS POSSIBLE AND PROTECTED DURING CONSTRUCTION.
4. THE SWALE AREAS SHALL NOT BE USED AS CONSTRUCTION STORAGE AREAS, I.E., PARKING OF EQUIPMENT, STORAGE AREA FOR MATERIALS, OR WASHOUT AREA FOR PAINTING, SHOT BLASTING, CONCRETE TRUCK WASHOUT, ETC.
5. IF SOIL IS REMOVED AS PER ALTERNATE FOR THE SWALE BOTTOMS, THE SOIL SPECIFIED IS TO BE OF A SIMILAR VARIETY TO THAT USED SPECIFICATION, AND SHALL BE CHOSEN TO HAVE A LOW PERCENTAGE OF FINE SILTS AND CLAYS AT ITS POINT OF ORIGIN.
6. SWALE BERMS OR INFILTRATION BASINS ARE TO BE 2:1 MAXIMUM UNLESS OTHERWISE INDICATED ON PLAN.
7. WATER CONTAINED IN THE INFILTRATION SWALES SHOULD PERCOLATE WITHIN 72 HOURS FOR POSSIBLE MOSQUITOES AND AVOID ALL ODOROUS CONDITIONS. IF STANDING WATER IS OBSERVED IN THE SWALES BEYOND THIS TIME PERIOD DURING CONSTRUCTION, THE CONTRACTOR WILL BE RESPONSIBLE TO REMEDIATE THE PROBLEM AND REPORT TO THE SATISFACTION OF THE OWNER OR THE CONTRACTORS EXPENSE.
8. SEDIMENT TRAPS TO CONTINUALLY BE MAINTAINED FROM ENTERING AREAS DESIGNATED AS INFILTRATION BASINS DURING CONSTRUCTION.
9. DURING CONSTRUCTION OF THE INFILTRATION SWALE USE THE SMALLEST/LIGHTEST EQUIPMENT PRACTICAL TO MINIMIZE COMPACTION.
10. IF TOPSOIL IS IMPORTED IN THE CONSTRUCTION OF THE SWALE, SELECT A SOIL WHICH IS OF SIMILAR TEXTURE AND POROSITY TO THE EXISTING SOIL (SEE STANDARD SPECIFICATIONS FOR IMPORTED TOPSOIL).
11. EVENLY INSTALL IMPORTED TOPSOIL TO MINIMIZE COMPACTION.
12. PLANT AND MAINTAIN SITE VEGETATION SHOWN AS SEEDS AFTER EXCAVATION AS POSSIBLE TO MINIMIZE AND REDUCE EROSION.

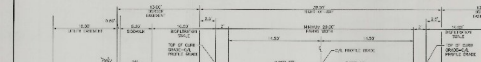
SEE DETAIL
SEE DETAIL
SEE DETAIL

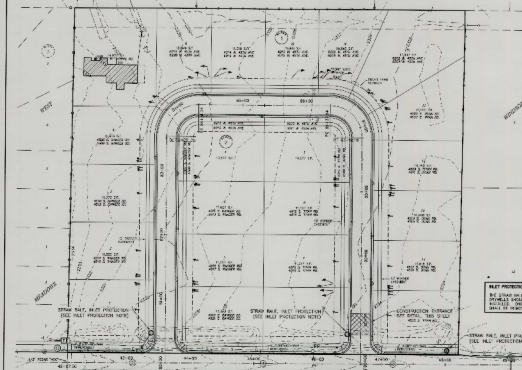

EROSION AND SEDIMENTATION CONTROL NOTES

1. THE FOLLOWING CONSTRUCTION SEQUENCE SHALL BE FOLLOWED IN ORDER TO BEST MINIMIZE SILT POTENTIAL FOR EROSION AND SEDIMENTATION CONTROL DURING BUILDING:
   a. CLEAR AND GRUB SUFFICIENTLY FOR INSTALLATION OF TEMPORARY ESC DEVICES;
   b. INSTALL TEMPORARY ESC DEVICES, CONSTRUCTION ENTRANCE, STRAW BALES AND SILT FENCE AT THE FIRST STEEP SLOPES OR DRAINAGE;
   c. CLEAR, GRUB AND ROUGH GRADE FOR ROADS, TEMPORARY ACCESS POINTS AND UTILITY LOCATIONS;
   d. STABILIZE PERMANENT APPROACHES AND TEMPORARY ACCESS POINTS WITH THE APPROPRIATE CONSTRUCTION ENTRY BMP;
   e. EXCAVATE, GRADE AND SHAPE INDIVIDUAL LOTS OR GROUPS OF LOTS;
   f. IMMEDIATELY STABILIZE, THROUGH RE-VEGETATION OR OTHER APPROPRIATE BMPS, LOTS OR GROUPS OF LOTS IN WHICH WORK HAS BEEN COMPLETED THAT ON FILL SLOPES 3H:1V, OR GREATER;
   g. CONSTRUCT ROADS, BUILDINGS, PERMANENT STORMWATER FACILITIES (ALL INLETS, PONDS, AND PIPELINES, ETC.);
   h. PROTECT ALL PERMANENT STORMWATER FACILITIES INTENDED TO APPROPRIATE BMPS;
   i. INSTALL PERMANENT ESC CONTROLS, WHEN APPLICABLE; AND
   j. REMOVE TEMPORARY ESC CONTROLS WHEN:
2. PERMANENT ESC CONTROLS, WHEN APPLICABLE, HAVE BEEN COMPLETELY INSTALLED;
3. ALL LAND-DISTURBING ACTIVITIES HAVE CEASED, THE POTENTIAL TO CAUSE EROSION OR SEDIMENTATION PROBLEMS HAVE CEASED; AND
4. VEGETATION HAS BEEN ESTABLISHED IN THE AREAS NOTED AS REQUIRING VEGETATION ON THE ACCEPTED ESC PLAN ON PAST 3RD, 5TH, 7TH, 10TH, GENERATION.
5. INSPECT ALL ROADWAYS, AT THE END OF EACH DAY, ADJACENT TO THE CONSTRUCTION ACCESS ROAD. IF IT IS EVIDENT THAT SEDIMENT HAS BEEN TRANSPORTED OFF SITE AND/OR ENTERED STE TEMPORARY DRYWELL DRAINAGE IS REQUIRED.
6. IF SEDIMENT REMAINS, IS NECESSARY WORK TO REMOVE SEDIMENT. IT SHALL BE REMOVED BY SWEEPING OR PICK-UP SWEEPING AND DISPOSED TO A CONTROLLED DISPOSAL SITE.
7. IF STREET WASHING IS REQUIRED TO REMOVE SEDIMENT TRACKED OFF SITE, ONCE SEDIMENT HAS BEEN REMOVED, STREET WASH WASTEWATER SHALL BE CONTROLLED BY PUMPING BACK ON SITE OR OTHERWISE PREVENTED FROM ENTERING INTO SITE LAND DRAINAGE BY MEANS OF ESC SITE.
8. REVIEW CONSTRUCTION ACCESS POINTS EQUAL TO OR BETTER THAN THE PRE-CONSTRUCTION CONDITION.
9. RETAIN THE DUFF LAYER, NATIVE TOPSOIL AND NATURAL VEGETATION IN AN UNDISTURBED STATE TO THE MAXIMUM EXTENT PRACTICAL.
10. INSPECT SEDIMENT CONTROL BMPS WEEKLY AT A MINIMUM, DAILY DURING A STORM EVENT, AND AFTER ANY DISCHARGE FROM THE SITE (EXCEPTIONS MAY BE NON-STORMWATER). THE INSPECTION FREQUENCY MAY BE REDUCED TO ONCE A MONTH IF ALL SITE STABILIZED AND INACTIVE.
11. CONTROL FUGITIVE DUST FROM CONSTRUCTION ACTIVITY IN ACCORDANCE WITH THE STATE AND/OR LOCAL AIR QUALITY CONTROL AUTHORITIES WITH AMBIENT DUST BEING KEPT ON THE PROJECT AREA.
12. STRAWBALE EXPOSED UNDERNEATH SOME EXCAVATIONS (STOCKPILES, WHICHEVER AS FINAL GRADE OR NOT, BEFORE 14 DAYS OF INACTIVITY. IF THE STOCKPILE IS NOT COMPLETED WITHIN 14 DAYS OF INACTIVITY, THE STOCKPILE SHALL BE COVERED WITH PLASTIC SHEETING